

Map No. _____ Sec. 236 Twp. 27 R. 5
Well No. 4 Gates Farm
Gates O & S, Company

WEST

EAST

SOUTH

COMPLETED

Rig Up-----

Drilling Remarks:

PRODUCTION

1st 24 hrs. Nat. -----

1st 24 hrs. after shot-----

Gas ----- cu. ft.

Dry Hole_____

Abandoned_ _ _ _ _

Map No. _____ Sec. 36 Twp. 27 R. 5

Well No. # 4 Yates Farm
Yates Oil & Gas Company

Ft. from N. Line


1120
~~1320~~

Ft. from S. Line

Ft. from E. Line

200

Ft. from W. Line

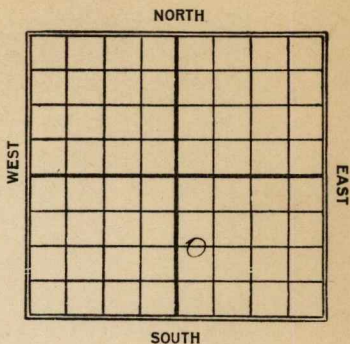

Date _____

REPORT

1922

7/22

Dec 1960

8/28

Sand 2649-66 - Shot
40 gts. 175 Bbls.

Map No. Kans 11 Sec. 34 Twp. 27 R. 5Well No. 4 YatesYates Oil Co. Company

Contractor

FIRST REPORT

Ft. from N. Line

1320 Ft. from S. Line

Ft. from E. Line

200 Ft. from W. Line

SECTION PLAT

		0	

Location

Rig up

Drilling and Remarks:

20 lg 1960'

RECORD

Cased _____ in., _____ ft.

Sand _____

Gas _____

Oil _____

Total Depth _____

PRODUCTION

1st 24 hrs. Nat. _____

1st 24 hrs. after shot _____

Gas _____ Cu. Ft.

Dry Hole _____

Abandoned _____

Date

JUL 22 1922

M. A. BENEAR

191

Scout

Map No. Kans 11 Sec. 36 Twp. 27 R. 5Well No. 4 Yates.Yates Oil Company

Contractor

COMPLETED

SECTION PLAT

Not 1320 from S.

0

Ft. from N. Line

1120' Ft. from S. Line

Ft. from E. Line

200' Ft. from W. Line

Location

Rig up

Drilling and Remarks:

shot 40 gts.

RECORD

Cased _____ in., _____ ft.

Sand 2649-66

Gas _____

Oil _____

Total Depth 2666

PRODUCTION

1st 24 hrs. Nat. _____

1st 24 hrs. after shot 175

Gas _____ Cu. Ft.

Dry Hole _____

Abandoned _____

Date

AUG 28 1928

M. A. BENEAR

Scout