


Section 4 Township 27 Range 6E

Well No. #2 Tatum

Company Murfin Drlg.

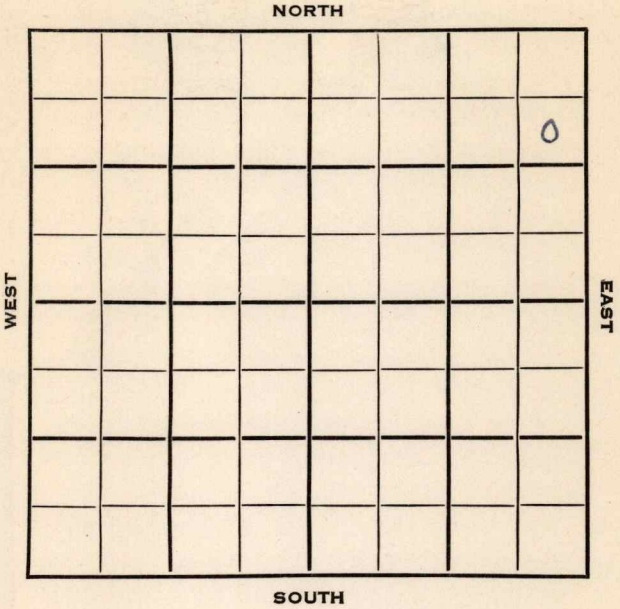

Butler

KANSAS

Sec. 4 Twp. 27 R. 6 E

Well No. # 2 Tatum Farm

Murfin Drlg. Company

Murfin Drlg. Contractor

Reynolds-Schaffer Pool


NORTH

990 Ft. from N. Line

\_\_\_\_\_ Ft. from S. Line

330 Ft. from E. Line

\_\_\_\_\_ Ft. from W. Line

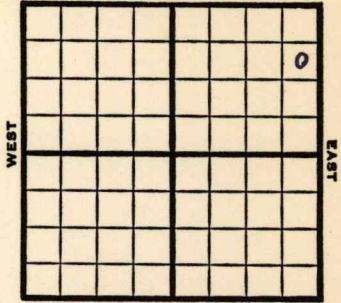

SE NE NE

1953 **Elev. 1428'** REPORT

4/22 Location

6/21 Spud 5-18-53  
 Oil Well  
 TD 2818  
 13" @ 365  
 10" @ 1037  
 8" @ 1882  
**KC 2142, Miss 2791**  
 7" @ 2791  
 DD 2818, 1000A  
 Comp. 25 bopd

**COMPLETED**



