KANSAS

FORM 51 IOM 12-46 PETROL


Butler

Section 5 Township 27 Range 6-E

Well No. 1 Beadles

Company Dunn & Strait

Miscellaneous

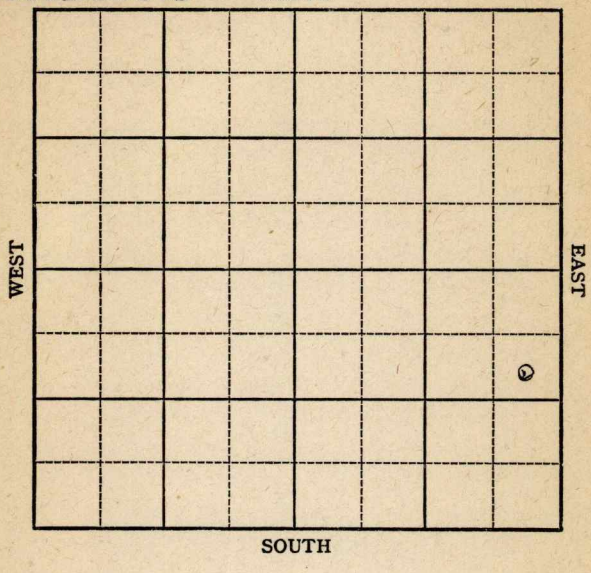

FORM 252-A
5M 6-46 PETROL

KANSAS Butler

Sec. 5 Twp. 27 R. 6-E

Well No. 1 Beadles Farm

Dunn & Strait Company

Miscellaneous


990 Ft. from N. Line

Ft. from S. Line

330 Ft. from E. Line

Ft. from W. Line

SE NE SE

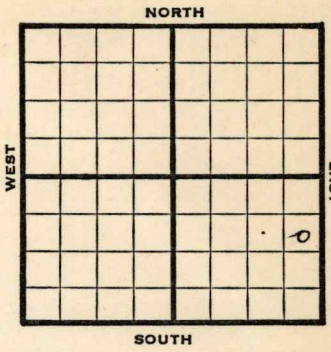

1947 Elev. REPORT 1396'

8/13
13" @ 758'
10" @ 1540'
KC 2120
8" @ 2270
Miss. 2759
7" @ 2759
Drlg. 2781

8/20
Drlg 3073'

8/27
Viola 3135'
5" @ 3103'
Pump 35 Pot
Gr. 38o
Total Depth 3137'

COMPLETED

Form 26 200 Bks. 10-46 Petrol

Kansas

Miscellaneous

Map No. _____ Sec. 5 Twp. 27 R. 6E

Well No. 1 Beadles

Dunn & Strait Company

FIRST REPORT Contractor

SE NE SE

990 Ft. from N. Line


_____ Ft. from S. Line

330 Ft. from E. Line

_____ Ft. from W. Line

Butler County

SECTION PLAT

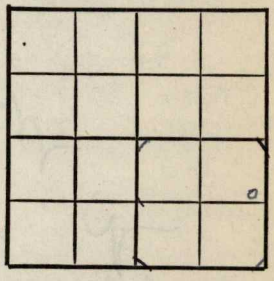

Location _____

Rig up _____

Drilling and Remarks:

13" @ 758
10" @ 1540
KC 2120
8" @ 2270
Miss. 2759
7" @ 2759
drlg. 2781

RECORD

Cased _____ in., _____ ft.

Sand _____

Gas _____

Oil _____

Total Depth _____

PRODUCTION

1st 24 hrs. Nat. _____

1st 24 hrs. after shot _____

Gas _____ Cu. Ft.

Dry Hole _____

Abandoned _____

Date

AUG 13 1947 19

S. J. LEWIS Scout

Form 26 200 Bks. 10-46 Petrol

Kansas

Miscellaneous

Map No. 11 Sec. 5 Twp. 27 R. 6E

Well No. 1 Beadles


Dunn & Strait Company

COMPLETE Contractor

SE NE SE

El. 1896

SECTION PLAT

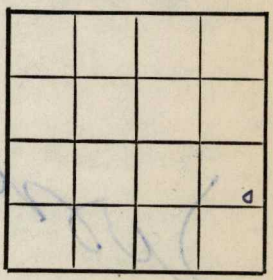

990 Ft. from N. Line

Ft. from S. Line

330 Ft. from E. Line

Ft. from W. Line

Butler County

Location

Rig up

Drilling and Remarks:

Viola 3135

5" @ 3103

Pump 80 BO

85% Gr

RECORD

Cased in., ft.

Sand

Gas

Oil

Total Depth 3107

PRODUCTION

1st 24 hrs. Nat.

1st 24 hrs. after shot

Gas Cu. Ft.

Dry Hole

Abandoned

Date

AUG 27 1947 19

S. J. LEWIS Scout