


Map No. Kansas Sec. 24 Twp. 32 R. 4

Well No. 2 Newman Farm  
Mc Knob Company

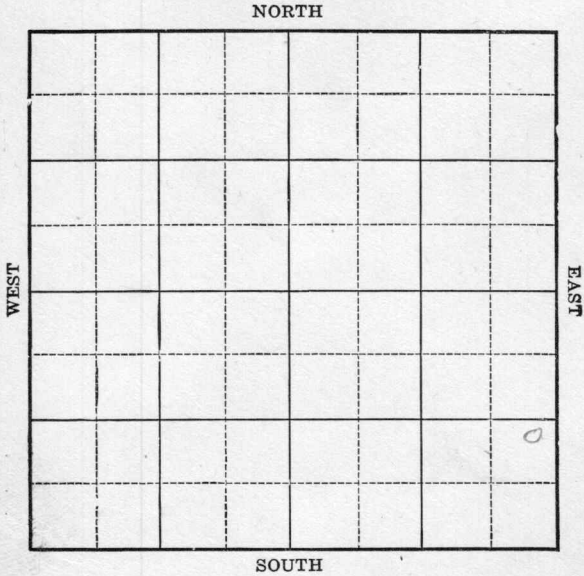

Location \_\_\_\_\_  
Drilling Remarks \_\_\_\_\_

Rig Up \_\_\_\_\_  
Drilling Remarks \_\_\_\_\_

\_\_\_\_\_  
\_\_\_\_\_  
**RECORD**

**PRODUCTION**

Cased \_\_\_\_\_ in. \_\_\_\_\_ ft.  
Sand \_\_\_\_\_  
Gas \_\_\_\_\_  
Oil \_\_\_\_\_  
Total Depth \_\_\_\_\_

1st 24 hrs. Nat. \_\_\_\_\_  
1st. 24 hrs. after shot \_\_\_\_\_  
Gas \_\_\_\_\_ cu. ft.  
Dry Hole \_\_\_\_\_  
Abandoned \_\_\_\_\_

Map No. Kane Sec. 24 Twp. 32 R 4


Well No. 2 Newman Farm  
Mc Knab Company

\_\_\_\_\_ Ft. from N. Line

1120 Ft. from S. Line

200 Ft. from E. Line

\_\_\_\_\_ Ft. from W. Line

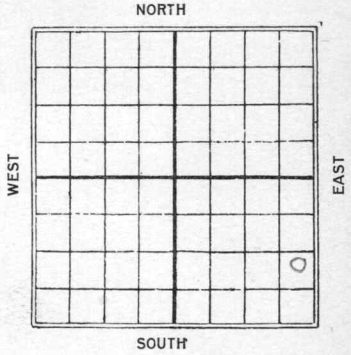

Date  
1925

REPORT

1/24 S. & A. 700

Map No. **KANSAS** Sec. 24 Twp. 32 R. 4

Well No. 2 Newman

Mc Knab Company

**FIRST REPORT** Contractor

**ABANDONED SECTION PLAT**

----- Ft. from N. Line

1120 Ft. from S. Line

200 Ft. from E. Line

----- Ft. from W. Line

			⊙

Location -----

Rig up -----

Drilling and Remarks:

4049  
700'

**RECORD**

Cased ----- in., ----- ft.

Sand -----

Gas -----

Oil -----

Total Depth -----

**PRODUCTION**

1st 24 hrs. Nat. -----

1st 24 hrs. after shot -----

Gas ----- Cu. Ft.

Dry Hole -----

Abandoned -----

Date

1/24 1926

**M. A. BENEAR**

Scout