

Cowley


FORM 51 IOM 12-46 PETROL

KANSAS

Section 24 Township 32 Range 4E

Well No. 4 Newman

Company Sinclair-Prairie

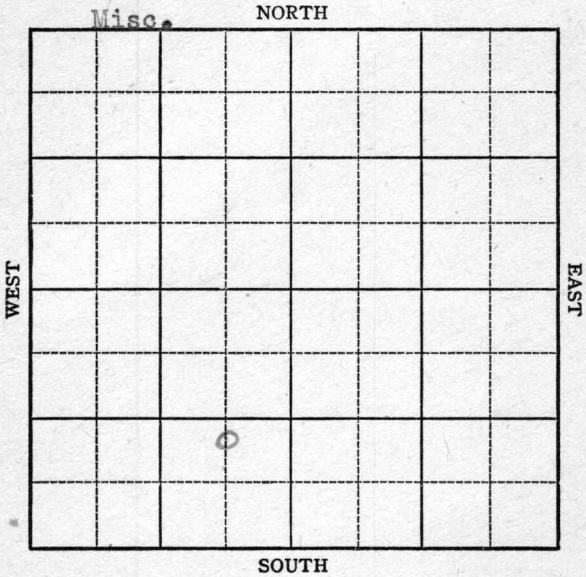

KANSAS

Cowley county

Sec. 24 Twp. 32 R. 4E

Well No. 4 Newman Farm

Sinclair-Prairie Company


Miscellaneous

_____ Ft. from N. Line

1120 Ft. from S. Line

630 Ft. from E. Line

_____ Ft. from W. Line

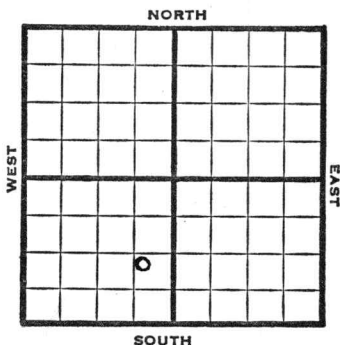

C N L SE SW

1947

Elev. 1216' REPORT

- 6/25 Location
- 7/1 "
- 7/8 Surface hole.
- 7/16 15" @ 66'
Drlg 360'
- 7/22 530 fsg.
- 7/29 Drlg 750'
- 8/6 TD 805'
Fishing
- 8/13 "
- 8/20 "
- 8/27 Drlg. 980'
- 9/3 Drlg. 1210'
- 9/10 Drlg. 1240'
- 9/17 Elgin 1390'
Drlg. 1480'
- 9/24 8" @ 1615'
Drlg. 1681'
- 10/1 1901 UR 8"
- 10/8 1891 N 8"

OVER

1947

10/15 Drlg. 1995'

10/22 Drlg. 2202
8" @ 2029

10/29 Layton 2328'-2330'
Under reaming 8"

11/12 Layton 2328'
Total Depth 2410'

ABANDONED

Map No. _____ Sec. 24 Twp. 32 R. 4E

Well No. 4 Newman

Sinclair-Prairie Company

FIRST REPORT

Contractor

C N L SE SW

SECTION PLAT

_____ Ft. from N. Line

1120 Ft. from S. Line

630 Ft. from E. Line

_____ Ft. from W. Line

| | | | |
|--|--|--|--|
| | | | |
| | | | |
| | | | |
| | | | |

Cowley County

Location X

Rig up _____

Drilling and Remarks:

RECORD

Cased _____ in., _____ ft.

Sand _____

Gas _____

Oil _____

Total Depth _____

PRODUCTION

1st 24 hrs. Nat. _____

1st 24 hrs. after shot _____

Gas _____ Cu. Ft.

Dry Hole _____

Abandoned _____

Date

JUN 25 1947 19

S. J. LEWIS Scout

