


Section 4 Township 27 Range 6-E

Well No. #1 Sarah Tatum

Company H. & M. Drilling

NORTH Reynolds Shaffer Pool

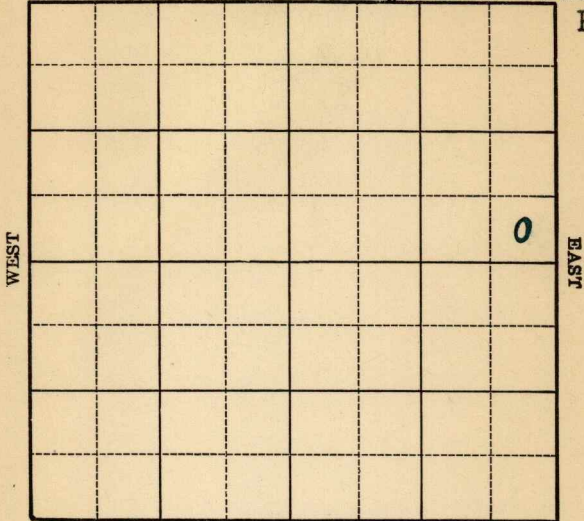

SOUTH

Sec. 4 Twp. 27 R. 6-E

Well No. #1 Sarah Tatum Farm

H & M Drilling Company

(Reynolds Shaffer)


\_\_\_\_\_ Ft. from N. Line

470 Ft. from S. Line

320 Ft. from E. Line

\_\_\_\_\_ Ft. from W. Line

**Elev. 1426**

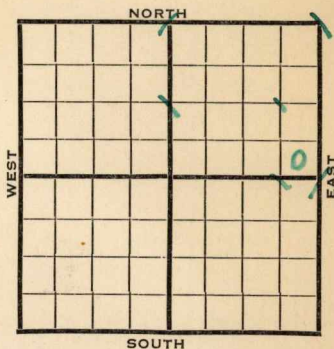

1940	REPORT
7/31	T.D. 767' Running 12½"
8/8	Drlg. 1475'
8/14	10" - 1854'
	Drlg. 1982'
8/22	8" - 2240' SD 2300'
8/29	6" - 2405' <b>Miss. 2775'</b>
	T.D. 2815' 700' fluid, 70% Wtr.
	5" - 2775'
9/4	<b>Miss. 2775'</b>
	5" - 2775'
	T.D. 2832'
	Water.

**ABANDONED**



Map No. 11 Sec. 4 Twp. 27 R. 6E

Well No. 1 Sarah Tatum

H & M Drilling Company

Contractor

ABANDONED

SE NE

SECTION PLAT

         Ft. from N. Line

470 Ft. from S. Line

320 Ft. from E. Line

         Ft. from W. Line


REYNOLDS SHAFFER POOL

Location                                 

Rig up                                 

Drilling and Remarks:

*Sh 2 2775  
5" C 2775  
Water*

RECORD

Cased                  in.,                  ft.

Sand                                 

Gas                                 

Oil                                 

Total Depth 2832

PRODUCTION

1st 24 hrs. Nat.                                 

1st 24 hrs. after shot                                 

Gas                                  Cu. Ft.

Dry Hole                                 

Abandoned                                 

Date

SEP 4 1940

S. J. LEWIS Scout