


Map No. Kansas Sec. 24 Twp. 32 R. 4

Well No. 1 C. D. Newman Farm  
Mc Knab Company

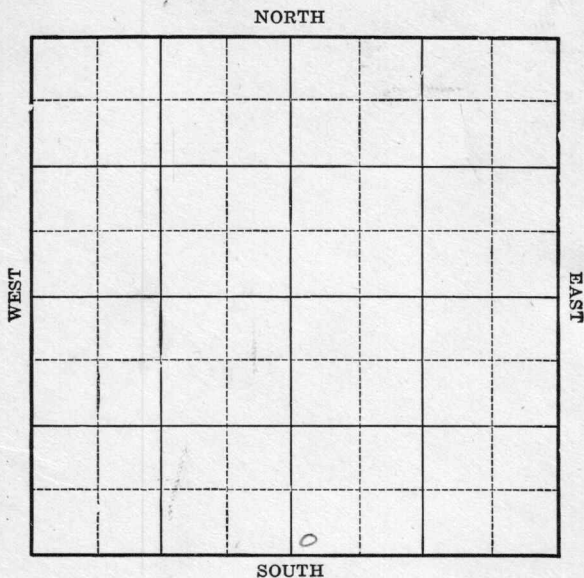

Location \_\_\_\_\_

Drilling Remarks

\_\_\_\_\_

\_\_\_\_\_

**RECORD**

Cased \_\_\_\_\_ in. \_\_\_\_\_ ft.

Sand \_\_\_\_\_

Gas \_\_\_\_\_

Oil \_\_\_\_\_

Total Depth \_\_\_\_\_

Rig Up \_\_\_\_\_

Drilling Remarks

\_\_\_\_\_

\_\_\_\_\_

**PRODUCTION**

1st 24 hrs. Nat. \_\_\_\_\_

1st. 24 hrs. after shot \_\_\_\_\_

Gas \_\_\_\_\_ cu. ft.

Dry Hole \_\_\_\_\_

Abandoned \_\_\_\_\_

Map No. *Kans* Sec. *24* Twp. *32* R *4*


Well No. *1 C. D. Newman* Farm  
*Mc Knab* Company

..... Ft. from N. Line

*200* Ft. from S. Line

..... Ft. from E. Line

*200* Ft. from W. Line

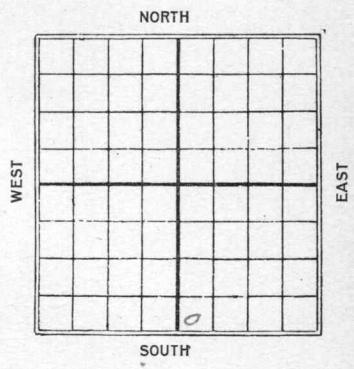

Date  
*1925*

REPORT

*1/24* *D. & A. 680*

Map No. **KANSAS** Sec. 24 Twp. 32 R. 4

Well No. 1 C.H. Newman

M<sup>c</sup> Knaf. Company

**FIRST REPORT** Contractor

**ABANDONED**

**SECTION PLAT**


----- Ft. from N. Line

200 Ft. from S. Line

----- Ft. from E. Line

200 Ft. from W. Line

Location -----

Rig up -----

Drilling and Remarks:

10x9  
680'

**RECORD**

Cased ----- in., ----- ft.

Sand -----

Gas -----

Oil -----

Total Depth -----

**PRODUCTION**

1st 24 hrs. Nat. -----

1st 24 hrs. after shot -----

Gas ----- Cu. Ft.

Dry Hole -----

Abandoned -----

Date

**M. A. BENEAR**

1/24 1925

Scout