


Map No. _____ Sec. 6 Twp. 32 R. 5
Well No. 1 Elrad Farm _____
Mullikin Company _____

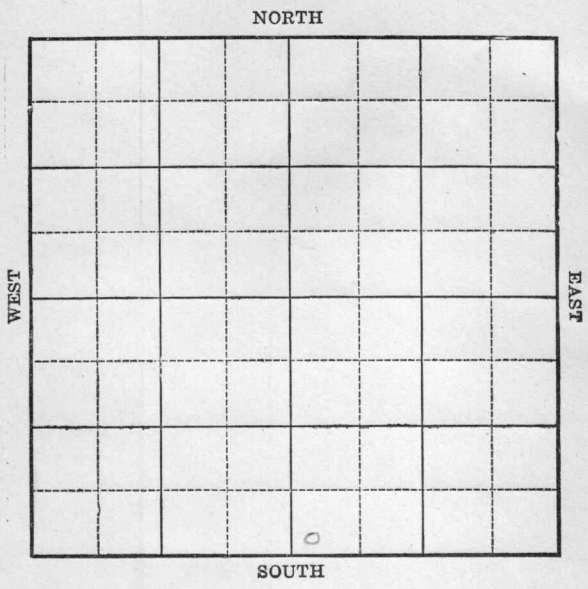

Location _____

Drilling Remarks:

Rig up _____

Drilling Remarks:

RECORD

Cased _____ in. _____ ft.

Sand _____

Gas _____

Oil _____

Total Depth _____

PRODUCTION

1st 24 hrs Nat. _____

1st 24 hrs. after shot _____

Gas _____ cu. ft.

Dry Hole _____

Abandoned _____

Map No. **KANSAS** Sec. **6** Twp. **32** R. **5**

Well No. **1 Elrod**

Milliken Company

Contractor

SECTION PLAT

FIRST REPORT

----- Ft. from N. Line

200 Ft. from S. Line

----- Ft. from E. Line

200 Ft. from W. Line

Location -----

Rig up -----

Drilling and Remarks:

Ran up.

RECORD

Cased ----- in., ----- ft.

Sand -----

Gas -----

Oil -----

Total Depth -----

PRODUCTION

1st 24 hrs. Nat. -----

1st 24 hrs. after shot -----

Gas ----- Cu. Ft.

Dry Hole -----

Abandoned -----

Date

APR 20 1923

M. A. BENEAR

----- 192-----

----- Scout

KANSAS

Map No. _____ Sec. 6 Twp. 32 R. 5

Well No. 1 E 1/2 Sec 6

Milliken

Company _____

Contractor _____

COMPLETED SECTION PLAT

_____ Ft. from N. Line

200 Ft. from S. Line

_____ Ft. from E. Line

200 Ft. from W. Line

Location _____

Rig up _____

Drilling and Remarks:

sand 2355-63

10/15 11/15

RECORD

Cased _____ in., _____ ft.

Sand _____

Gas _____

Oil _____

Total Depth _____

PRODUCTION

1st 24 hrs. Nat. _____

1st 24 hrs. after shot _____

Gas _____ Cu. Ft.

Dry Hole _____

Abandoned _____

Date

AUG 4 1923

M. A. BENEAR

192

Scout