

KANSAS

Section 5 Township 32 Range 5-E

Well No. #1 Shelby

Company C V Stewart
Miscellaneous

NORTH

⊙							

WEST

EAST

SOUTH



Sec. 5 Twp. 32 R. 5E


Well No. #1 Shelby Farm
C. V. Stewart Company
Misc.

990 Ft. from N. Line

_____ Ft. from S. Line

_____ Ft. from E. Line

330 Ft. from W. Line

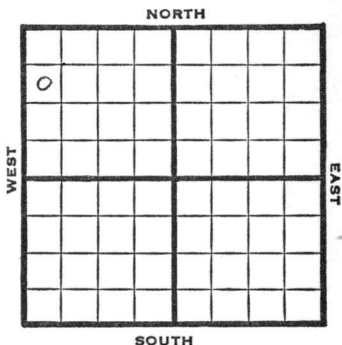

SW NW NW

1948 Elev. 1260' REPORT

6/1 13" @ 135'
Drlg. 990'

6/9 Layton 2317'
TD 2408'
Abd.

ABANDONED

Map No. _____ Sec. 5 Twp. 32 R. 5E

Well No. 1 Shelby

C. V. Stewart Company

FIRST REPORT Contractor

SW NW NW


SECTION PLAT

990 Ft. from N. Line

_____ Ft. from S. Line

_____ Ft. from E. Line

330 Ft. from W. Line

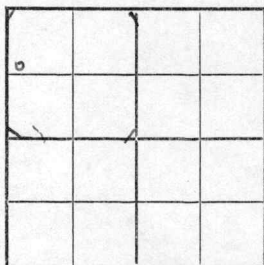

Cowley County

Location _____

Rig up _____

Drilling and Remarks:

13" @ 135

drlg. 990

RECORD

Cased _____ in., _____ ft.

Sand _____

Gas _____

Oil _____

Total Depth _____

PRODUCTION

1st 24 hrs. Nat. _____

1st 24 hrs. after shot _____

Gas _____ Cu. Ft.

Dry Hole _____

Abandoned _____

Date

JUN 1 1948 19

S. J. LEWIS Scout

Map No. 2 Sec. 5 Twp. 32 R. 5E

Well No. 1 Shelby

C. V. Stewart Company

ABANDONED Contractor

SW NW NW

E1,1260

SECTION PLAT

990 Ft. from N. Line

_____ Ft. from S. Line

_____ Ft. from E. Line

330 Ft. from W. Line

o			

Cowley County

Location _____

Rig up _____

Drilling and Remarks:

Layton 2317

RECORD

Cased _____ in., _____ ft.

Sand _____

Gas _____

Oil _____

Total Depth 2408

PRODUCTION

1st 24 hrs. Nat. _____

1st 24 hrs. after shot _____

Gas _____ Cu. Ft.

Dry Hole _____

Abandoned _____

Date

JUN 9 1948 19

S. J. LEWIS Scout