


Butler

Form 51-5M-4-27-27423

Map No. **KANSAS** Sec. 5 Twp. 27 R. 6^E

Well No. 5 - Doughty Farm
Blue Stem Oil Company

NORTH

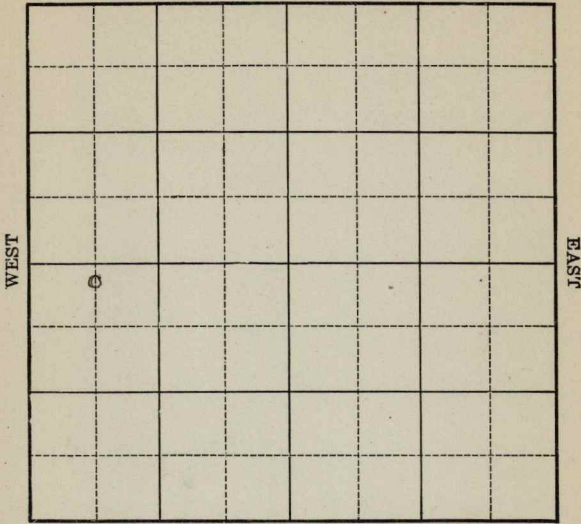

SOUTH

Location _____

Drilling Remarks _____

Rig Up _____

Drilling Remarks _____

RECORD

Cased _____ in. _____ ft.

Sand _____

Gas _____

Oil _____

Total Depth _____

PRODUCTION

1st 24 hrs. Nat. _____

1st 24 hrs. after shot _____

Gas _____ cu. ft.


Dry Hole _____

Abandoned _____

Map No. **KANSAS** Sec. 5 Twp. 27 R. 6^E

Well No. 5 Doughty Farm
Blue Stem Oil Company

200 Ft. from N. Line
 Ft. from S. Line
 Ft. from E. Line
660 Ft. from W. Line

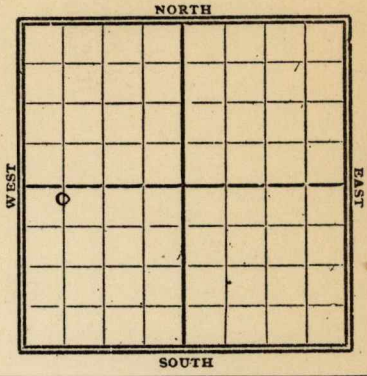

1928

| Date | REPORT |
|-------|--------------------------------|
| 8/22 | <u>Rig up.</u> |
| 8/28 | <u> </u> |
| 9/4 | Drlg 900' |
| 9/12 | " 1200 |
| 9/19 | " 2170' |
| 9/26 | show oil & HFW 2585' |
| | Drlg 2620' |
| 10/3 | sand 2715-59' |
| | shot 100 gts - swab 30 bbl hr. |
| 10/10 | <u> </u> |
| 10/17 | sand 2715-59-T.D. |
| | 100/500 bbl oil |
| | <u>Gas up</u> |

Butler

11 **KANSAS** SEC. 5 TWP. 77 R. 6^E

WELL NO. 5
Bus Stem Oil Co COMPANY

CONTRACTOR

FIRST REPORTS

SECTION PLAT

| | | | |
|---|--|--|--|
| | | | |
| | | | |
| o | | | |
| | | | |

200 FT. FROM N. LINE
 _____ FT. FROM S. LINE
 _____ FT. FROM E. LINE
 660 FT. FROM W. LINE

LOCATION _____

RIG UP

DRILLING AND REMARKS:

RECORD

CASED _____ IN. _____ FT.
 SAND _____
 GAS _____
 OIL _____
 TOTAL DEPTH _____

PRODUCTION

1ST 24 HRS. NAT. _____
 1ST 24 HRS. AFTER SHOT _____
 GAS _____ CU. FT.
 DRY HOLE _____
 ABANDONED _____

DATE

AUG 22 1928

CHAS. L. SHERWOOD

192

SCOUT

Butler

K11 KANSAS

MAP NO. _____ SEC. 5 TWP. 27 R. 6

WELL NO. 5 Doughty

Blue Stem Oil Co COMPANY

CONTRACTOR

COMPLETED SECTION PLAT

200 FT. FROM N. LINE

_____ FT. FROM S. LINE

_____ FT. FROM E. LINE

660 FT. FROM W. LINE

| | | | |
|---|--|--|--|
| | | | |
| | | | |
| o | | | |
| | | | |

LOCATION _____

RIG UP _____

DRILLING AND REMARKS:

100 / 500 lbs.

RECORD

CASED _____ IN. _____ FT.

SAND 2715-2759

GAS _____

OIL _____

TOTAL DEPTH 2759

PRODUCTION

1ST 24 HRS. NAT. _____

1ST 24 HRS. AFTER SHOT _____

GAS _____ CU. FT.

DRY HOLE _____

ABANDONED _____

DATE

OCT 17 1928

CHAS. L. SHERWOOD

192

SCOUT