



Map No. \_\_\_\_\_ Sec. 6 Twp. 32R 5


Well No. 4 - Elrod Farm  
Milligan et al Company

330 Ft. from N. Line

\_\_\_\_\_ Ft. from S. Line

\_\_\_\_\_ Ft. from E. Line

330 Ft. from W. Line

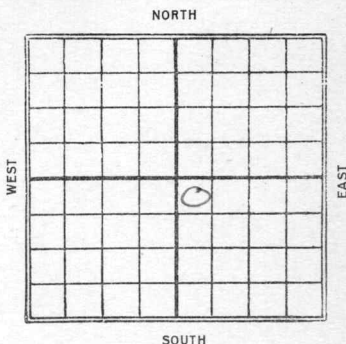

1927

Date

REPORT

Date	REPORT
8/18	Drig 430'
8/24	" 1150
9/1	" 1650
9/7	" 2275
9/28	2325 - 2342 1/2
	30/105 bbls

Cowley  
33

K2 KANSAS  
Map No. \_\_\_\_\_ Sec. 16 Twp. 33 R. 5

Well No. 4  
\_\_\_\_\_

Milligan et al Company

\_\_\_\_\_ Contractor

### FIRST REPORTS

### SECTION PLAT

330 Ft. from N. Line

\_\_\_\_\_ Ft. from S. Line

\_\_\_\_\_ Ft. from E. Line

330 Ft. from W. Line

		0	

Location \_\_\_\_\_

Rig up \_\_\_\_\_

Drilling and Remarks:

lg 430'

### RECORD

Cased \_\_\_\_\_ in., \_\_\_\_\_ ft.

Sand \_\_\_\_\_

Gas \_\_\_\_\_

Oil \_\_\_\_\_

Total Depth \_\_\_\_\_

### PRODUCTION

1st 24 hrs. Nat. \_\_\_\_\_

1st 24 hrs. after shot \_\_\_\_\_

Gas \_\_\_\_\_ Cu. Ft.

Dry Hole \_\_\_\_\_

Abandoned \_\_\_\_\_

Date

AUG 18 1927

CHAS. L. SHERWOOD

192

Scout

*Cowley*

Map No. 2 KANSAS Sec. 6 Twp. 32 R. 5

Well No. 4

*Milligan et al*

Company

Contractor

COMPLETED

SECTION PLAT

*330*

Ft. from N. Line

Ft. from S. Line

Ft. from E. Line

*330*

Ft. from W. Line

		o	

Location

Rig up

Drilling and Remarks:

*20/105 BR*

RECORD

Cased \_\_\_\_\_ in., \_\_\_\_\_ ft.

Sand *2325-2342 1/2*

Gas \_\_\_\_\_

Oil \_\_\_\_\_

Total Depth *2342 1/2*

PRODUCTION

1st 24 hrs. Nat. \_\_\_\_\_

1st 24 hrs. after shot \_\_\_\_\_

Gas \_\_\_\_\_ Cu. Ft.

Dry Hole \_\_\_\_\_

Abandoned \_\_\_\_\_

Date

*SEP 28 1927*

CHAS. L. SHERWOOD