


Form 51-5M-7-25-19786

Map No. Kansas Sec. 5 Twp. 27 R. 6

Well No. 1 Ecker Farm

B. F. Branson et al Company

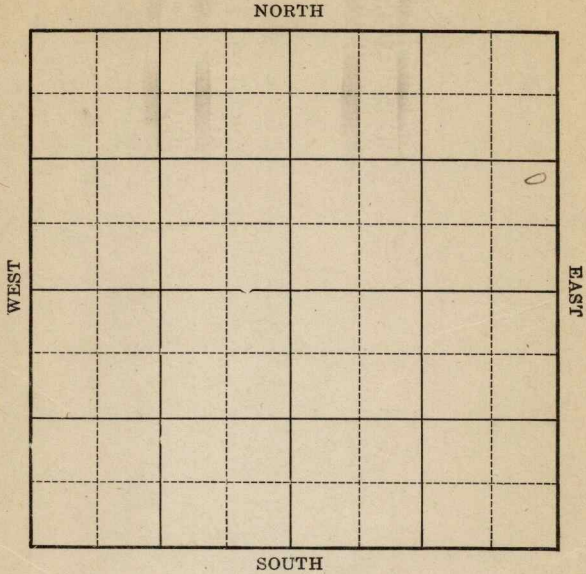

Location _____

Drilling Remarks _____

Rig Up _____

Drilling Remarks _____

RECORD

Cased _____ in. _____ ft.

Sand _____

Gas _____

Oil _____

Total Depth _____

PRODUCTION

1st 24 hrs. Nat. _____

1st 24 hrs. after shot _____

Gas _____ cu. ft.

Dry Hole _____

Abandoned _____

Map No. Kansas Sec. 5 Twp. 27 R. 6Well No. 1 Eckey Beattie FarmBranson et al Company

NORTH

Ft. from N. Line

1120 Ft. from S. Line200 Ft. from E. Line

Ft. from W. Line

WEST

EAST

SOUTH

C OWSS OWSS

Date

REPORT

<u>1925</u>	
<u>3/24</u>	<u>Location</u>
<u>6/12</u>	<u>S.D. 2700</u>
<u>1/10</u>	<u>2785-2809 40 gts</u> <u>15 Bbls</u>
<u>1925</u>	<u>{ OWSS }</u>
<u>8/18</u>	<u>Rigging up</u>
<u>8/20</u>	<u>Only to 2882 No air</u> <u>or water running</u> <u>tubing + will pump</u> <u>from Original sand</u> <u>record.</u>
<u>8/27</u>	<u>sand 2785-2809 - 2.D. 2882'</u> <u>pumping 15 bbls</u>
<u>1926</u>	<u>{ OWSS }</u>
<u>3/25</u>	<u>Drilling deeper</u>
<u>4/7</u>	<u>S.D. 2930</u>
<u>4/14</u>	<u>Drilling 2950</u>
<u>4/21</u>	<u>" 3025</u>
<u>4/31</u>	<u>" 3112</u>
<u>5/8</u>	<u>" 3194</u>
<u>5/12</u>	<u>"</u>

519 - Top line 2828'
Hfw. 3192-3212'
Sta. 3215'

11
 Map No. **KANSAS** Sec. 5 Twp. 27 R. 6
Well No. 2 BeatlesBranson et al Company

Contractor

FIRST REPORT

-----Ft. from N. Line

1120 Ft. from S. Line200 Ft. from E. Line

-----Ft. from W. Line

SECTION PLAT

			0

Location ✓✓

Rig up -----

Drilling and Remarks:

RECORD

Cased ----- in., ----- ft.

Sand -----

Gas -----

Oil -----

Total Depth -----

PRODUCTION

1st 24 hrs. Nat. -----

1st 24 hrs. after shot -----

Gas ----- Cu. Ft.

Dry Hole -----

Abandoned -----

Date

3/24 1925

M. A. BENEAR

Scout

Butler
 K11 KANSAS Sec. *5* Twp. *27* R. *6*
 Well No. *1 6069*
D. F. Bran Aon Inc Company

Contractor

FIRST REPORTS

SECTION PLAT

_____Ft. from N. Line

1120 _____Ft. from S. Line*200* _____Ft. from E. Line

_____Ft. from W. Line

"old" 2785-2809' old hand record

Location _____

Rig up _____

Drilling and Remarks:

*Tap line 2928**only 2910'*

RECORD

Cased _____ in., _____ ft.

Sand _____

Gas _____

Oil _____

Total Depth _____

PRODUCTION

1st 24 hrs. Nat. _____

1st 24 hrs. after shot _____

Gas _____ Cu. Ft.

Dry Hole _____

Abandoned _____

Date

MAR 25 1926

CHAS. L. SHERWOOD

192_____

Scout

Map No. 17 1/2 Sec. 5 Twp. 27 R. 6Well No. 2 FerrisBranson & Co Company

Contractor

COMPLETED

Ft. from N. Line

1120 Ft. from S. Line200 Ft. from E. Line

Ft. from W. Line

SECTION PLAT

			o

Location

Rig up

Drilling and Remarks:

40/15 bls

RECORD

Cased _____ in., _____ ft.

Sand 2785-2809

Gas _____

Oil _____

Total Depth 2809

PRODUCTION

1st 24 hrs. Nat. _____

1st 24 hrs. after shot _____

Gas _____ Cu. Ft.

Dry Hole _____

Abandoned _____

Date

JUL 10 1925192**CHAS. L. SHERWOOD**

Scout

Map No. **KANSAS** Sec. **5** Twp. **27** R. **6**

Well No. **1** **Ferris**
Drake Bros & Co Company

Contractor

FIRST REPORTS

SECTION PLAT

Ft. from N. Line

1120 Ft. from S. Line

700 Ft. from E. Line

Ft. from W. Line

Producing well going deeper.

Location

Rig up

Drilling and Remarks:

L.D. 2809'

Bigging up.

			0

RECORD

Cased _____ in., _____ ft.

Sand _____

Gas _____

Oil _____

Total Depth _____

PRODUCTION

1st 24 hrs. Nat. _____

1st 24 hrs. after shot _____

Gas _____ Cu. Ft.

Dry Hole _____

Abandoned _____

Date

AUG 14 1925

192

CHAS. L. SHERWOOD

Scout

Returned
Cards
Tracing
France Map
Scarborough Map
Moody Map
Scarborough Plat Book
Moody Plat Book

Charley our map shows
 This #2 Well located
 in NE SE NE Your
 1st Reports shows same
 Advise if number has
 been changed to #1 as
 your Carry on this ticket.

Returned
Cards
Tracing
France Map
Scarborough Map
Moody Map
Scarborough Plat Book
Moody Plat Book

11 KANSAS Sec. 5 Twp. 27 R. 6

Well No. 1 Ferris

Blk on own & ad Company

Correct from #2 to #1
map Contractor

{ CORRECTION }

SECTION PLAT

			0

Ft. from N. Line

1120 Ft. from S. Line

200 Ft. from E. Line

Ft. from W. Line

Producing well going deeper

Location

Rig up

Drilling and Remarks:

J. D. 2809'

digging up.

chq well to from #2 to #1.

RECORD

Cased _____ in., _____ ft.

Sand _____

Gas _____

Oil _____

Total Depth _____

PRODUCTION

1st 24 hrs. Nat. _____

1st 24 hrs. after shot _____

Gas _____ Cu. Ft.

Dry Hole _____

Abandoned _____

Date

AUG 18 1925

192

CHAS. L. SHERWOOD

Scout

Map No. ¹¹ KANSAS Sec. ⁵ Twp. ²⁷ R. ⁶

Well No. ¹ *Ferris*
Braden Company

Contractor

COMPLETED

SECTION PLAT

-----Ft. from N. Line

1120 -----Ft. from S. Line

200 -----Ft. from E. Line

-----Ft. from W. Line

			0

Location -----

Rig up -----

Drilling and Remarks:

RECORD

Cased ----- in., ----- ft.

Sand *2785-2809'*

Gas -----

Oil -----

Total Depth *2882'*

PRODUCTION

1st 24 hrs. Nat. -----

1st 24 hrs. after shot -----

Gas ----- Cu. Ft.

Dry Hole -----

Abandoned -----

Date

AUG 27 1925

192

CHAS. L. SHERWOOD

Scout

Pumping 15 bhs

Map No. *K11* **KANSAS** Sec. *5* Twp. *27* R. *6*

Well No. *1* *Section*
B. J. Brandon Company

Contractor

COMPLETED

_____ Ft. from N. Line

1120 _____ Ft. from S. Line

200 _____ Ft. from E. Line

_____ Ft. from W. Line

old well deeper

SECTION PLAT

			6

ABANDONED

Location _____

Rig up _____

Drilling and Remarks:

Top line 2828'
KFW 3192-3212'

DAQ 3215'

RECORD

Cased _____ in., _____ ft.

Sand _____

Gas _____

Oil _____

Total Depth *3215'*

PRODUCTION

1st 24 hrs. Nat. _____

1st 24 hrs. after shot _____

Gas _____ Cu. Ft.

Dry Hole ☒

Abandoned ☒

Date

MAY 12 1926

192

CHAS. L. SHERWOOD

Scout