


Section 6 Township 32 Range 5E

Well No. #6 Elrod "B"

Company C. V. Stewart

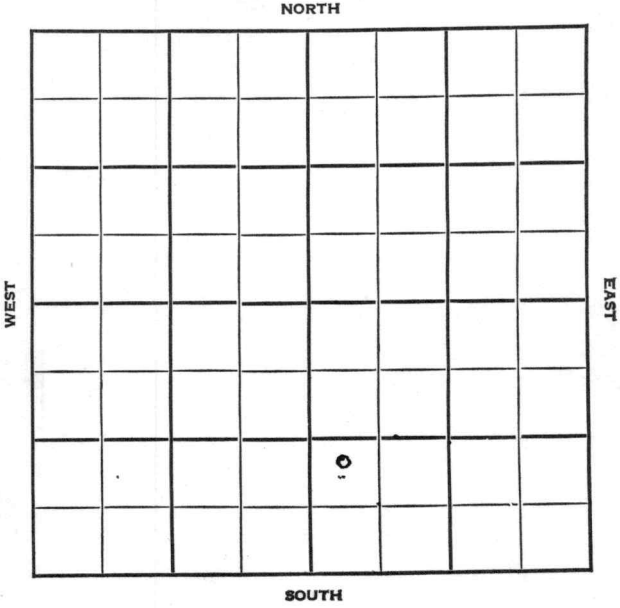



Sec. 6 Twp. 32 R. 5E

Well No. #6 Elrod "B" Farm

C. V. Stewart Company

Misc.


_____ Ft. from N. Line

1200 Ft. from S. Line

_____ Ft. from E. Line

330 Ft. from W. Line

NW SW SE

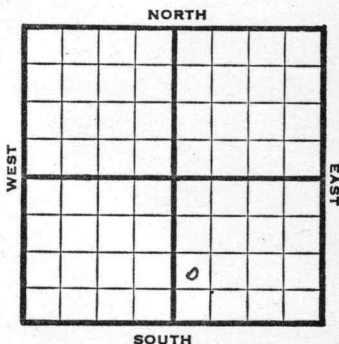

1948 Elev. 1267' REPORT

1/28 8" @ 115'
Drlg. 2114'

2/4 TD 2321'
5" @ 2316'

2/11 Layont 2312'

2/18 "

2/25 "

3/3 "

3/10 "

3/17 "

3/24 Layton 2319' Corrected
TD 2333'

3/31 10 qts 2322-31 CO

4/7 Layton 2319'
5" @ 2316'
10 qts 2322-31
Pump 10 Pot.
Gr. 38°
TD 2333'

COMPLETED

Map No. _____ Sec. 6 Twp. 32 R. 5E

Well No. 6 Elrod "B"

C. V. Stewart Company

FIRST REPORT Contractor

NW SW SE

SECTION PLAT

		o	

_____ Ft. from N. Line

1200 Ft. from S. Line

_____ Ft. from E. Line

330 Ft. from W. Line

Cowley County

RECORD

Location _____

Cased _____ in., _____ ft.

Rig up _____

Sand _____

Drilling and Remarks:

Gas _____

8" @ 115

Oil _____

drlg. 2114

Total Depth _____

PRODUCTION

1st 24 hrs. Nat. _____

1st 24 hrs. after shot _____

Gas _____ Cu. Ft.

Dry Hole _____

Abandoned _____

Date

JAN 28 1948

19

S. J. LEWIS Scout

Map No. 2 Sec. 6 Twp. 32 R. 5E

Well No. 6 Elrod "B"

C. V. Stewart Company

COMPLETE Contractor

NW SW SE

E/1267
SECTION PLAT

 Ft. from N. Line

1200 Ft. from S. Line

 Ft. from E. Line

330 Ft. from W. Line

		o	

Cowley County

Location

Rig up

Drilling and Remarks:

Log 2319
Log 2316
log to 2322-81
Pump 10 ft
35% Se

RECORD

Cased in., ft.

Sand

Gas

Oil ✓

Total Depth 2329

PRODUCTION

1st 24 hrs. Nat.

1st 24 hrs. after shot

Gas Cu. Ft.

Dry Hole

Abandoned

Date

APR 7 1948 19

S. J. LEWIS Scout