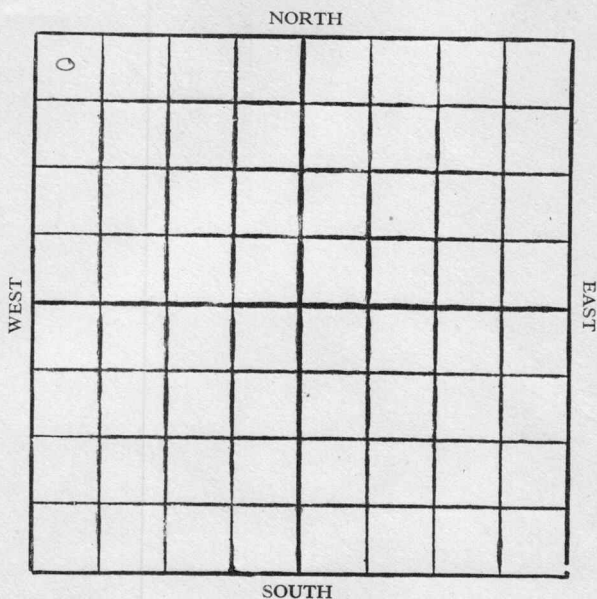


Butler

Map No. 15 Sec. 17 Twp. 28 R. 3EWell No. Staley Farm
Kinderschal Company

Location

Drilling Remarks

.....

.....

.....

.....

.....

.....

.....

.....

.....

.....

RECORD

Cased in. ft.

Sand

Gas

Oil

Total Depth

Rig Up

Drilling Remarks

.....

.....

.....

.....

.....

.....

.....

.....

.....

.....

PRODUCTION

1st 24 hrs. Nat.

1st 24 hrs. after shot

Gas cu. ft.

Dry Hole

Abandoned


Map No. *Ks* Sec. *17* Twp. *28* R. *3 E*Well No. *1- Staley* Farm
Findeiss et al Company

NORTH

300 Ft. from N. Line

Ft. from S. Line

Ft. from E. Line

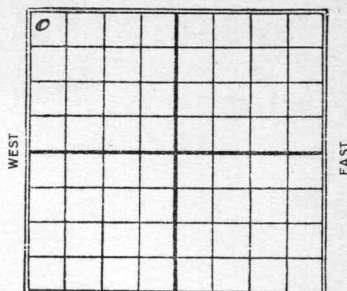300 Ft. from W. Line

SOUTH

Date

REPORT

<i>1926</i>	
<i>12/8</i>	<i>Location</i>
<i>12/15</i>	<i>same</i>
<i>12/21</i>	<i>—</i>
<i>12/29</i>	<i>—</i>
<i>1927</i>	
<i>1/5</i>	<i>—</i>
<i>1/12</i>	<i>—</i>
<i>1/19</i>	<i>—</i>
<i>1/26</i>	<i>Rigging up</i>
<i>2/2</i>	<i>spud</i>
<i>2/9</i>	<i>Spud 350</i>
<i>2/16</i>	<i>Drlg 560</i>
<i>2/23</i>	<i>" 785</i>
<i>3/2</i>	<i>" 1210</i>
<i>3/9</i>	<i>" 1885</i>
<i>3/16</i>	<i>" 2020</i>
<i>3/23</i>	<i>Drlg 2450 H.F.W.</i>
<i>3/30</i>	<i>Sand 2576 - 77 - 2 bbl. showoil</i>
	<i>Drilling 2583</i>
<i>4/6</i>	<i>Top line 2870 - Drlg 2933</i>
<i>4/13</i>	<i>Top line 2870 - 3048 Base</i>
	<i>Top Wilcox 3148 - Drlg 3148</i>
<i>4/20</i>	<i>Drlg 3233</i>

4/25- T.D. 3303 (measured) Lewis (26)

4/27- T.D. 3303 - S.D. Contract depth

5/4- T.D. 3303 - D & A

12 Butler

Map No. **KANSAS** Sec. 17 Twp. 28 R. 3E

Well No. 1 Staley

Finckleis & Co. Company

Contractor

SECTION PLAT

300 Ft. from N. Line

Ft. from S. Line

Ft. from E. Line

300 Ft. from W. Line

0			

FIRST REPORTS

Location

Rig up

Drilling and Remarks:

Location

RECORD

Cased _____ in., _____ ft.

Sand _____

Gas _____

Oil _____

Total Depth _____

PRODUCTION

1st 24 hrs. Nat. _____

1st 24 hrs. after shot _____

Gas _____ Cu. Ft.

Dry Hole _____

Abandoned _____

Date

DEC 8 - 1926

192

S. J. LEWIS

Scout

Map No. 12 KANSAS Sec. 17 Twp. 28 R. 3E

Well No. 1 Staley

Findeiss & Co Company

Contractor

SECTION PLAT

300 Ft. from N. Line

_____ Ft. from S. Line

_____ Ft. from E. Line

300 Ft. from W. Line

<u>0</u>			

ABANDONED

Location _____

Rig up _____

Drilling and Remarks:

TD 3303

II & A

RECORD

Cased _____ in., _____ ft.

Sand _____

Gas _____

Oil _____

Total Depth _____

PRODUCTION

1st 24 hrs. Nat. _____

1st 24 hrs. after shot _____

Gas _____ Cu. Ft.

Dry Hole _____

Abandoned _____

Date

MAY 4 1927

S. J. LEWIS

Scout

MAP NO. KANSAS SEC. 17 TWP. 28S R. 3E

WELL NO. 1

Funderburk COMPANY

CONTRACTOR

ABANDONED

SECTION PLAT

0			

_____ FT. FROM N. LINE

_____ FT. FROM S. LINE

_____ FT. FROM E. LINE

_____ FT. FROM W. LINE

LOCATION _____

RIG UP _____

DRILLING AND REMARKS:

2870 2L
3091 Base
3157 1/2 2N
3172 OK

RECORD

CASED _____ IN. _____ FT.

SAND _____

GAS _____

OIL _____

TOTAL DEPTH 3302

PRODUCTION

1ST 24 HRS. NAT. _____

1ST 24 HRS. AFTER SHOT _____

GAS _____ Cu. Ft.

DRY HOLE ☒

ABANDONED ☒

DATE

Apr 16 192 7

SCOUT