

KANSAS


FORM 51 5M 10-41 PETROL

Cowley

Section 31 Township 30 Range 6-E

Well No. #1 Crawley (Crawley)

Company Nelson Drilling

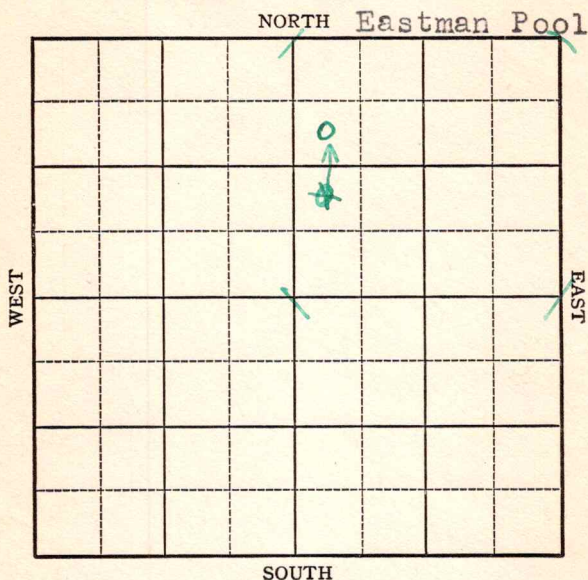

Cowley


KANSAS

Map No. 11 Sec. 31 Twp. 30 R. 6EWell No. 1 CrawleyNelson Drilling CompanyFIRST REPORT Contractor

NW SW NE

 Ft. from N. Line990 Ft. from S. Line Ft. from E. Line330 Ft. from W. Line

SECTION PLAT

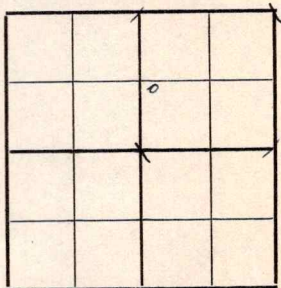

EASTMAN POOL

Location XXXRig up

Drilling and Remarks:

RECORD

Cased in., ft.Sand Gas Oil Total Depth

PRODUCTION

1st 24 hrs. Nat. 1st 24 hrs. after shot Gas Cu. Ft.Dry Hole Abandoned

Date

MAR 1 8 1942 19S. J. LEWIS Scout

Cowley

KANSAS


Map No. 11 Sec. 31 Twp. 30 R. 6 EWell No. 1 CrawleyNelson Drilling Company
CORRECTION

Contractor

SW NW NE

990 Ft. from N. Line Ft. from S. Line Ft. from E. Line330 Ft. from W. Line

SECTION PLAT

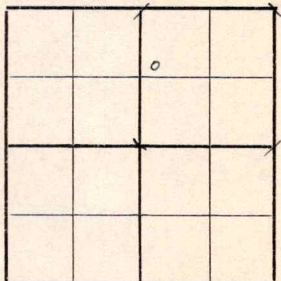EASTMAN POOLLocation Rig up

Drilling and Remarks:

ReportedNW SW NE

RECORD

Cased in., ft.Sand Gas Oil Total Depth

PRODUCTION

1st 24 hrs. Nat. 1st 24 hrs. after shot Gas Cu. Ft.Dry Hole Abandoned

Date

MAR 25 1942

19

S. J. LEWIS Scout

KANSAS

Cowley

Map No. 11 Sec. 31 Twp. 30 R. 6EWell No. 1 CrawleyNelson Drilling Company

ABANDONED

Contractor

SW NW NE

990 Ft. from N. Line Ft. from S. Line Ft. from E. Line330 Ft. from W. Line

SECTION PLAT

		o	

EASTMAN POOL

Location Rig up

Drilling and Remarks:

*Bar Y2840**7" C2883**109 to 2903-15**No shows*

RECORD

Cased in., ft.Sand Gas Oil Total Depth 2943

PRODUCTION

1st 24 hrs. Nat. 1st 24 hrs. after shot Gas Cu. Ft.Dry Hole Abandoned

Date

MAY 6 1942 19

S. J. LEWIS Scout