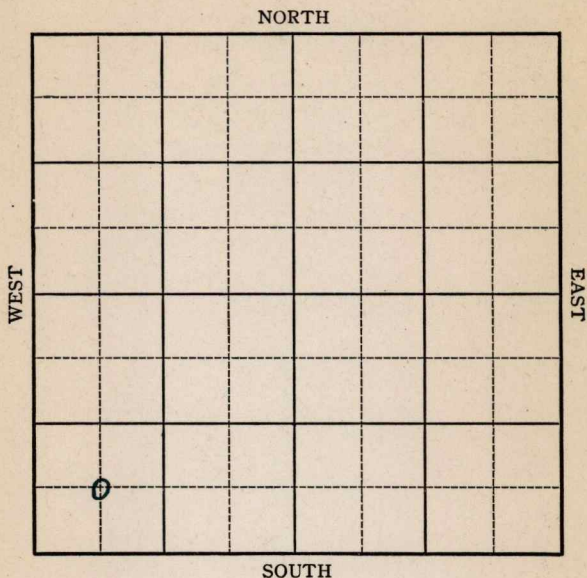



Section 5 Township 27 Range 6EWell No. 6McLeanCompany Jim Woods et al

KANSAS

Butler

Sec. 5 Twp. 27 R. 6-EWell No. #6 McLean FarmJim Woods et al Company

(Misc.)

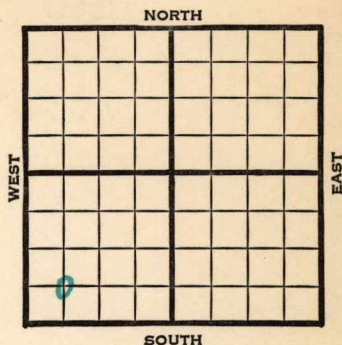 Ft. from N. Line660 Ft. from S. Line Ft. from E. Line660 Ft. from W. Line

1941

REPORT

6/4 Location

6/12 Machine.

6/19 Drlg. 345'

6/26 12" - 818' Drlg. 1275'

7/3 10" - 1472' K.C. 2125'

Drlg. 2170'

7/10 Miss. 2738' 7" - 2756'

Drlg. 2960'

7/16 Arb. 3169'

T.D. 3171'

Water.

ABANDONED

Map No. 11 Sec. 5 Twp. 27 R. 6EWell No. 6 McLeanJim Woods etal Company

Contractor

FIRST REPORT

C SW SW

 Ft. from N. Line660 Ft. from S. Line Ft. from E. Line660 Ft. from W. Line

MISCELLANEOUS

SECTION PLAT

o			

Location XRig up

Drilling and Remarks:

RECORD

Cased in., ft.Sand Gas Oil Total Depth

PRODUCTION

1st 24 hrs. Nat. 1st 24 hrs. after shot Gas Cu. Ft.Dry Hole Abandoned

Date

JUN 4 1941 19 S. J. LEWIS Scout

Map No. 11 Sec. 5 Twp. 27 R. 6EWell No. 6 McLeanJim Woods et al CompanyABANDONED ContractorC SW SW
Ft. from N. Line660 Ft. from S. Line

Ft. from E. Line

660 Ft. from W. Line

MISCELLANEOUS

SECTION PLAT

6			

Location _____

Rig up _____

Drilling and Remarks:

*Cr 8/8/69**Water*

RECORD

Cased _____ in., _____ ft.

Sand _____

Gas _____

Oil _____

Total Depth 3171

PRODUCTION

1st 24 hrs. Nat. _____

1st 24 hrs. after shot _____

Gas _____ Cu. Ft.

Dry Hole _____

Abandoned _____

Date

JUL 16 1941

19

S. J. LEWIS

Scout