


Section 6 Township 32 Range 5E

Well No. #1 Elrod "A"

Company C.V. Stewart

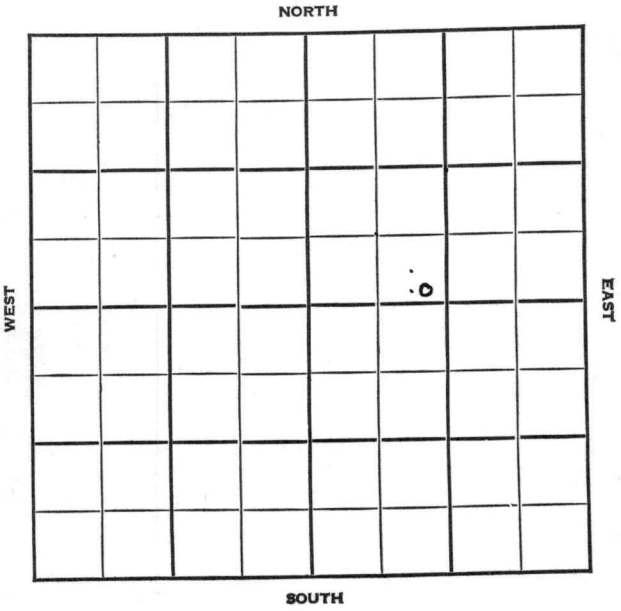



Sec. 6 Twp. 32 R. 5E

Well No. #1 Elrod "A" Farm

C. V. Stewart Company

Misc.


         Ft. from N. Line

150 Ft. from S. Line

         Ft. from E. Line

990 Ft. from W. Line

SE SW NE

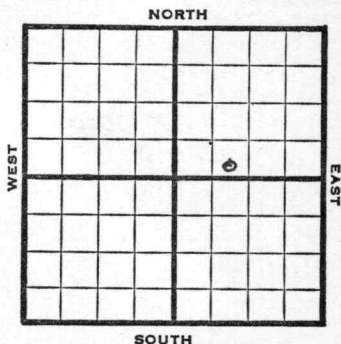

1948

Elev. 1231' REPORT

1/28

8" @ 215'

5" @ 2290'

TD 2295'

2/4

"

2/11

"

2/18

TD 2295'

2/25

TD 2310' - 8 qts. 2311'-18'  
~~1800~~ CO

3/3

"

3/10

Layton 2310'

5" @ 2290'

Pump 25 oil & 50% Water

Gr. 36°

TD 2318'

**COMPLETED**

Map No. \_\_\_\_\_ Sec. 6 Twp. 32 R. 5E

Well No. 1 Elrod "A"

C. V. Stewart Company

FIRST REPORT Contractor

SE SW NE

SECTION PLAT

\_\_\_\_\_ Ft. from N. Line

150 Ft. from S. Line

\_\_\_\_\_ Ft. from E. Line

990 Ft. from W. Line

		o	

Cowley County

Location \_\_\_\_\_

Rig up \_\_\_\_\_

Drilling and Remarks:

8" @ 215

5" @ 2290

TD<sup>1</sup> 2295

RECORD

Cased \_\_\_\_\_ in., \_\_\_\_\_ ft.

Sand \_\_\_\_\_

Gas \_\_\_\_\_

Oil \_\_\_\_\_

Total Depth \_\_\_\_\_

PRODUCTION

1st 24 hrs. Nat. \_\_\_\_\_

1st 24 hrs. after shot \_\_\_\_\_

Gas \_\_\_\_\_ Cu. Ft.

Dry Hole \_\_\_\_\_

Abandoned \_\_\_\_\_

Date

JAN 28 1948

19

S. J. LEWIS Scout

Map No. 2 Sec. 6 Twp. 32 R. 5E

Well No. 1 Elrod "A"


C. V. Stewart Company

COMPLETE Contractor

SE SW NE

E 1/2 3/4  
SECTION PLAT

         Ft. from N. Line  
150 Ft. from S. Line  
         Ft. from E. Line  
990 Ft. from W. Line

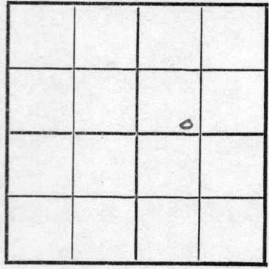

Cowley County

Location                                 

Rig up                                 

Drilling and Remarks:

*Lay 500 2810*  
*5" 22290*  
*Pump 25 oil 750%*  
*Water*  
*36 0 4*

RECORD

Cased          in.,          ft.  
Sand                                   
Gas                                   
Oil                                  ✓  
Total Depth 2818

PRODUCTION

1st 24 hrs. Nat.                           
1st 24 hrs. after shot                           
Gas                          Cu. Ft.  
Dry Hole                           
Abandoned                         

Date

MAR 10 1948 19 S. J. LEWIS Scout