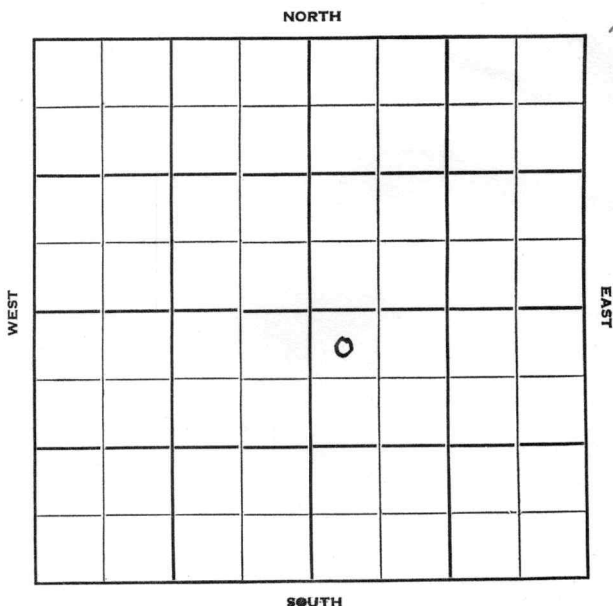


Barton KANSAS

Section 31 Township 17 Range 12 WWell No. # 3 Eveleigh - ArgoCompany Adair & Holly

Barton

KANSAS

Sec. 31 Twp. 17 R. 12W

Well No. #3 Eveleigh - Argo Farm

Adair & Holly Company

Fields Bros. - Contr. Contractor

Red Wing Pool


330' Ft. from N. Line

_____ Ft. from S. Line

_____ Ft. from E. Line

330' Ft. from W. Line

NW NW SE

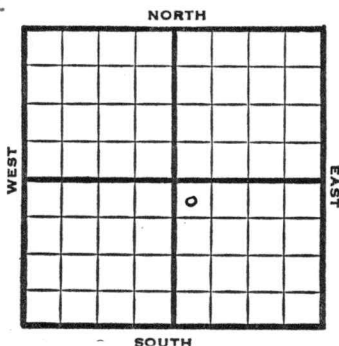

1951

Elev. 1816' REPORT

2/7

Spud 2-6-51

3/28

Spud 2-6-51

Oil Well TD 3335

Anby 700-35'

8" @ 212

Heeb. 2964

Br Lime 3063'

Lans. 3079

Arb. 3320-22

5" @ 3321

TD 3335

24/3323-35 FU 250' oil 12 hrs

B/1/2 BOPH 1000 A

S/1 boph 2500 A S/8 boph

Comp. 209 bopd 10% wtr

COMPLETED


County **Barton** State **Kansas**Sec. **31** (Blk.) **17** (Sur. Rge.) **12W** Map No.Operator **Adair & Holly**Well No. **3** Farm **Eveleigh - Argo**Elev. Location **NW NW SE**

330 Ft. From **N** Line **SE****330** Ft. From **W** Line Quarter1st. Report **FEB 7 1951**

Completion

Remarks

Fields Bros. - Contr.Spudding Date **2-6-51**Drlg. Data **Red Wing Pool****J. E. TYRA**

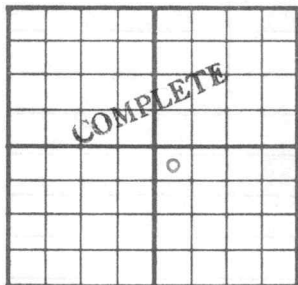County Barton State KansasSec. 31 (^{Blk.}_{Twp.}) 17 (^{Sur.}_{Rge.}) 12W Map No.Operator Adair & HollyWell No. 3 Farm Eveleigh - Argo ~~NAH~~Elev. 1816 Location NW NW SE ~~-KGS~~
~~DRV~~336 Ft. From N Line SE330 Ft. From W Line Quarter

1st. Report

Completion MAR 28 1951Remarks Red Wing PoolField Bros. - Contr.Spudding Date 2-6-51Drilg. Data Oil well TD 3335Anhy 700-35 8" @ 212 Heeb. 2964Br. lime 3063 Lans. 3079 Arb. 3320-225" @ 3321 TD 3335 24/ 3323-35FU 250' oil 12 hr. B/ $\frac{1}{2}$ boph1000 A S/ 1 boph 2500 A S/ 8 bophComp. 209 bopd. 10% water

J. E. TYRA