


McPherson
Form 51-5M-1-30-38840
Map No. KANSAS Sec. 19 Twp. 19 R. 14
Well No. 1- Sellers Farm
Dietz & Shell Company

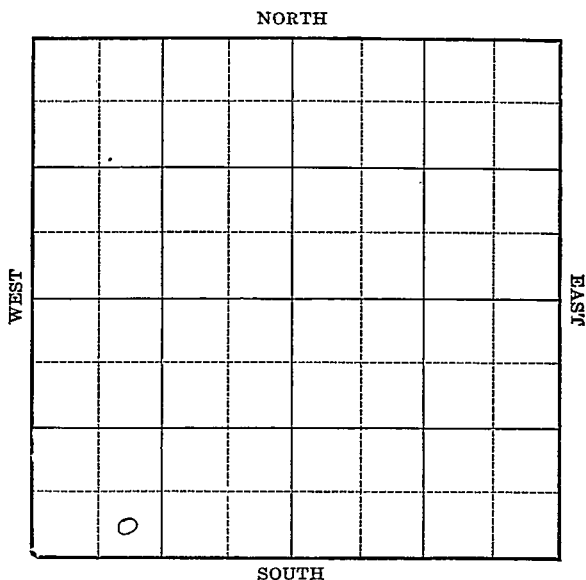

Location _____
Drilling Remarks _____

Rig Up _____
Drilling Remarks _____

RECORD


Cased _____ in. _____ ft.
Sand _____
Gas _____
Oil _____
Total Depth _____

PRODUCTION

1st 24 hrs. Nat. _____
1st 24 hrs. after shot _____
Gas _____ cu. ft.
Dry Hole _____
Abandoned _____

Map No. **KANSAS** Sec. 19 Twp. 19 R. 1^W
Well No. 1 - Sellers Farm
Pietur & Shew Company

NORTH

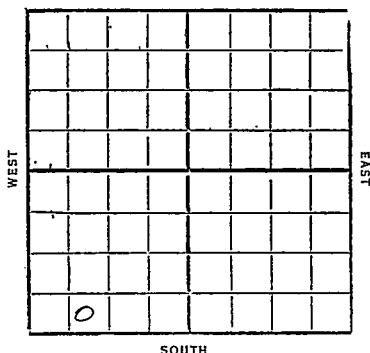

_____ Ft. from N. Line

330 Ft. from S. Line

_____ Ft. from E. Line

990 Ft. from W. Line

1930

Date

REPORT

12/10	Loc
12/17	Rob
12/23	Bldg rig
12/30	
1931	
1/7	Spud
1/14	Dreg 800'
1/21	UIC 10"-1490
1/28	Dreg 1900'
2/4	UIC 8"-2110'
2/11	8"-2340
	Dreg 2355'
2/18	Top Chat 2938
	set 6"-2938
	HFW at 2970
	Show oil 2995
	dreg 3015'
2/25	" 3095'
3/4	Base Miss 3155
	dreg 3170'
	(over)

3/11- Top Viola 3412

Pay 3415-25

T.D. 3425

filled up 3200' oil
in 4 3/4 hrs

3/18- Viola 3412-25

T.D. 3425

swab 1320 bal

Comp.

Map No. **KANSAS** Sec. 19 Twp. 19 R. 1W
43
 Well No. 1 Shell

Dieter & Shell Company

Contractor

SECTION PLAT

Ft. from N. Line

330 Ft. from S. Line

Ft. from E. Line

990 Ft. from W. Line

FIRST REPORTS

Location ✓

Rig up

Drilling and Remarks:

RECORD

Cased _____ in., _____ ft.

Sand _____

Gas _____

Oil _____

Total Depth _____

PRODUCTION

1st 24 hrs. Nat. _____

1st 24 hrs. after shot _____

Gas _____ Cu. Ft.

Dry Hole _____

Abandoned _____

Date

DEC 10 1930

© I. LEWIS Scout

M. Herion
 Map No. KANSAS Sec. 19 Twp. 19 R. 14

43
 Well No. 1 S. Herion

Pieten & Shell Company

Contractor

SECTION PLAT

6			

.....Ft. from N. Line

380 Ft. from S. Line

.....Ft. from E. Line

990 Ft. from W. Line

COMPLETED

Location.....

Rig up.....

Drilling and Remarks:

swath 1320 ft.

RECORD

Cased.....in.,ft.

Sand 3412 - 3425

Gas.....

Oil.....

Total Depth 3425

PRODUCTION

1st 24 hrs. Nat.....

1st 24 hrs. after shot.....

Gas.....Cu. Ft.

Dry Hole.....

Abandoned.....

Date

MAR 18 1931 192 S. J. LEWIS Scout