


Form 51-5M-2-29-34703

Map No. KANSAS Sec. 20 Twp. 19 R. 12W

Well No. 1-Kindmarsh Farm

Abilene & Shell Company

NORTH

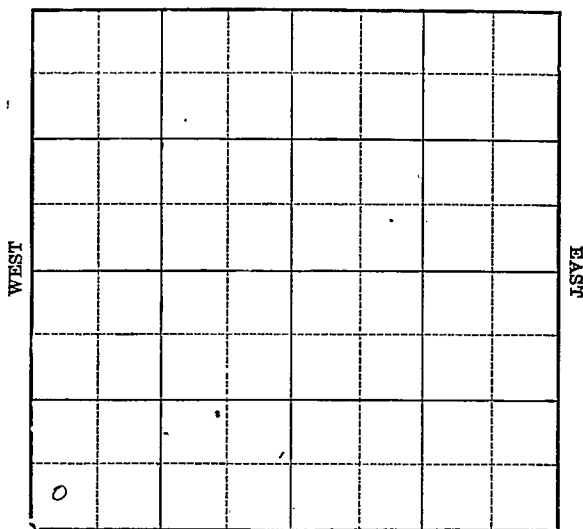

SOUTH

Location _____

Drilling Remarks _____

Rig Up _____

Drilling Remarks _____

RECORD

Cased _____ in. _____ ft.

Sand _____

Gas _____

Oil _____

Total Depth _____

PRODUCTION

1st 24 hrs. Nat. _____

1st 24 hrs. after shot _____

Gas _____ cu. ft.

Dry Hole _____

Abandoned _____

Map No. KANSAS Sec. 20 Twp. 19 R. 1^W
Well No. 1 - Hindmarsh Farm
Abilene & Shell Company


_____ Ft. from N. Line

330 Ft. from S. Line

_____ Ft. from E. Line

330 Ft. from W. Line

1931

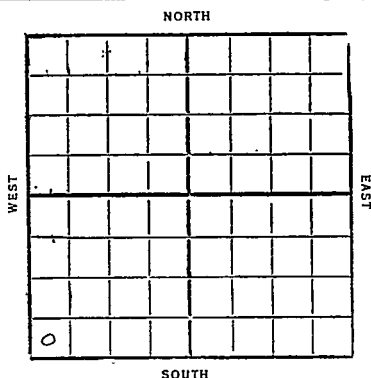

Date	REPORT
4/29	Loc
5/6	
5/13	Bldg rug
5/20	
5/27	Rug
6/3	—
6/10	—
6/17	—
6/24	—
7/1	—
7/8	
7/15	Drilg 410'
7/22	" 1075
7/29	13" 1495
	Drilg 1550'
8/5	" 2115
8/12	10" 2284
	drilg 2289
8/19	" 2645
8/26	Top Chat 2931
	T.D. 2935
	Perm 8" 2927

9/2- 4 # gas at 2951
show oil 2960-63
6"-2957

HFW 2980-3000
drlg 3020'

9/9- TD 3030' Fsg.

9/16- Drlg 3155

9/23- Viola 3425

TD 3435 1/2'

swab 210 bbl 5 hr
show water

9/30- SD 3435 1/2' TD.

10/7- TD 3435 1/2'

No test

10/14- TD 3437

No test

10/21

10/28- Viola 3425-37

TD 3437

Potential gauge

812 bbl oil

Comp.

McPherson

W

KANSAS

Map No. 43 Sec. 20 Twp. 19 R. 1

Well No. 1 Hino marsh

Abilene & Sheel Company

Contractor

FIRST REPORTS

SECTION PLAT

Ft. from N. Line

330 Ft. from S. Line

Ft. from E. Line

330 Ft. from W. Line

0			

Location ✓

Rig up

Drilling and Remarks:

RECORD

Cased in., ft.

Sand

Gas

Oil

Total Depth

PRODUCTION

1st 24 hrs. Nat.

1st 24 hrs. after shot

Gas Cu. Ft.

Dry Hole

Abandoned

Date

APR 29 1931

CHAS. L. SHERWOOD

192

Scout

McPherson
 43
 Map No. KANSAS Sec. 20 Twp. 19 R. 1 ^W
 Well No. 1 *Hinson*
Abilene *Shell* Company
 Contractor

COMPLETED

Ft. from N. Line

330 Ft. from S. Line

Ft. from E. Line

330 Ft. from W. Line

SECTION PLAT

Location

Rig up

Drilling and Remarks:

Potential
812 Bbs.

RECORD

Cased in. ft.Sand *brs* 3425-37

Gas

Oil

Total Depth 3437

PRODUCTION

1st 24 hrs. Nat.

1st 24 hrs. after shot

Gas Cu. Ft.

Dry Hole

Abandoned

Date

OCT 28 1931

CHAS. L. SHERWOOD

Scout