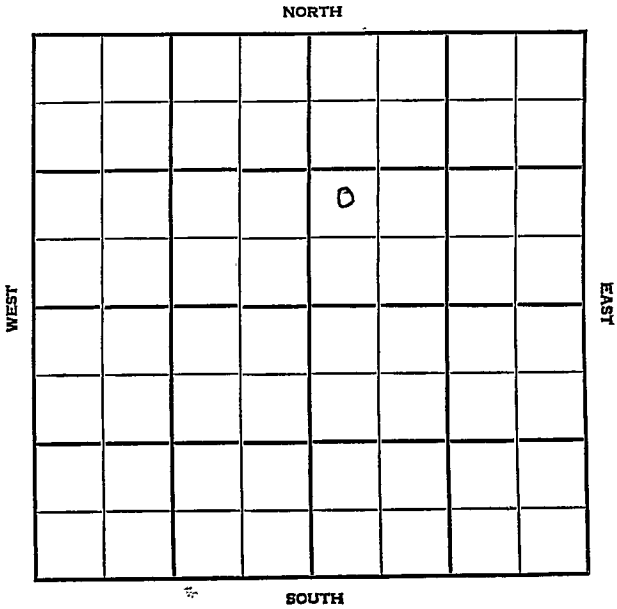


Section 20 Township 19 Range 1 WWell No. #1 KaegiCompany K & P Oil

McPherson

KANSAS

SEC. 20	TWP. 19	R. 1W
------------	------------	----------

WELL NO.

#1 Kaegi

FARM

COMPANY

K & P Oil

CONTRACTOR

Mallard

Ritz-Canton


Ft. from N. Line

Ft. from S. Line

Ft. from E. Line

Ft. from W. Line

NW SW NE

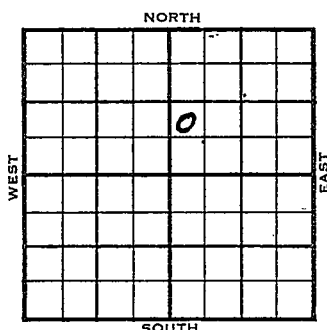

	ELEVATION	REPORT
1956	1575	

3-7 Comm. 3-3-56
8" @ 156/100
Drlg. 976

4-25 5½" @ 3404 w/50
DD 3440
DD 3455
PB 3200, 80/ 2998-3054,
FÜ 900' oil, 700' wtr.
Comp. 25 bopd, 33% wtr.
L. 2331
M. Cherty 2925
V. 3398
TD 3404'

COMPLETED

County McPherson Elev. _____
 Sec. 20 Twp. 19 Rgs. 1W
 Company H & P Oil
 FarmName Kaegi No. 1

TOPS	DEPTH	LOG	DATUM	Loc. in Sec.
Anh.				NW SW NE
TP.				
H.				
Tr.				
Dg.				
BL.				
L.				
K.C.				Geol. _____
B.K.C.				Contr. _____
Ce.				<u>Mallard</u>
C.				
M.				Pool _____
M.				<u>Ritz-Canton</u>
K.				
Mz.				
Mo.				
V.				
S.				
S.				
A.				
R.				
PE.				
G.				
T.D.				

FIRST REPORT

MAR 7 '56

Date Comm. 3-3-56
8" @ 156/100 drlg. 976

Handwritten signature/initials

County McPherson Elev. 1575
 Sec. 20 Twp. 19 Rge. 1W
 Company K & P Oil
 FarmName Kaegi No. 1

TOPS	DEPTH	LOG	DATUM	Loc. in Sec.
Anh.				NW SW NE
TP.				
H.				
Tr.				
Dg.				
BL.				
L.	<u>2331</u>		<u>756</u>	Geol.
K.C.				Contr.
B.K.C.				<u>Mallard</u>
Ce.				Pool
C.				<u>Ritz-Canton</u>
M. <u>Cherty</u>	<u>2925</u>		<u>1350</u>	
M.				
K.				
Mz.				
Me.				
V.	<u>3398</u>		<u>1823</u>	
S.				
S.				
A.				
R.				
Pe.				COMPLETE
G.				
TD.	<u>3404</u>			

Date Comm. 3-3-56 APR. 25 1956

8" @ 156/100 5 $\frac{1}{2}$ " @ 3404/50 DD 3440

DD 3455 PB 3200 80/ 2998-3054

FU 900' oil 700' wtr.

Comp. 25 bopd 33% wtr.