

KANSAS

Form 51-5M-7-40-Palace

Butler


Section 6 Township 27 Range 6-E

Well No. #6 Boghty

Company Mohawk Oil

Miscellaneous

NORTH

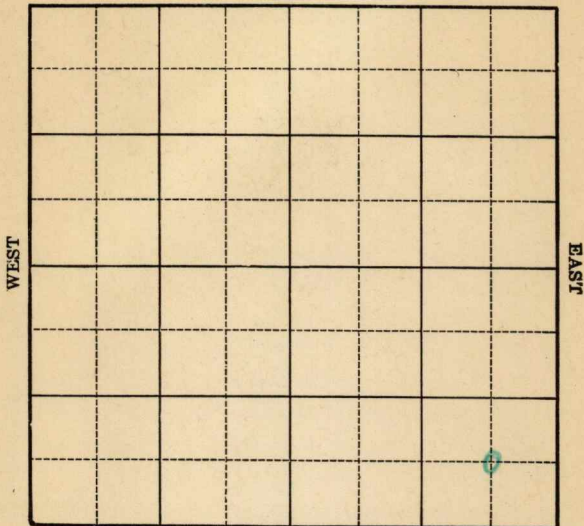

SOUTH

Sec. 6 Twp. 27 R. 6-E

Well No. #6 Boghty Farm

Mohawk Oil Company


(Misc.)

_____ Ft. from N. Line

660 Ft. from S. Line

660 Ft. from E. Line

_____ Ft. from W. Line

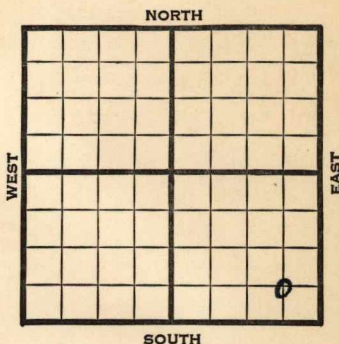

1941	REPORT
4/2	Spud 180'
4/10	12" - 820' 1490' run 10".
4/18	10" - 1490' Drlg. 2195'
4/24	8" - 2242' Drlg. 2715'
5/1	Miss. 2748' 6" - 2748'
	Viola 3100-02' T.D. Run 5".
5/8	5" - 3097' 1200' oil 14 hrs.
	P.B.P.
5/15	"
5/22	"
5/27	Viola 3100'
	5" - 3097'
	T.D. 3102'
	Potential 50 bbls., pump.
	36. Gravity
	COMPLETED

Map No. 11 Sec. 6 Twp. 27 R. 6E

Well No. 6 Boghty

Mohawk Oil Company

Contractor

FIRST REPORT

SECTION PLAT

C SE SE

 Ft. from N. Line

660 Ft. from S. Line

660 Ft. from E. Line

 Ft. from W. Line

			o

MISCELLANEOUS

Location

Rig up

Drilling and Remarks:

Spud 180'

RECORD

Cased in., ft.

Sand

Gas

Oil

Total Depth

PRODUCTION

1st 24 hrs. Nat.

1st 24 hrs. after shot

Gas Cu. Ft.

Dry Hole

Abandoned

Date

APR 2 1941 19

S. J. LEWIS Scout

Map No. 11 Sec. 6 Twp. 27 R. 6E

Well No. 6 Boghty

Mohawk Oil Company

Contractor

COMPLETED

SECTION PLAT

C SE SE

			o

 Ft. from N. Line

660 Ft. from S. Line

660 Ft. from E. Line

 Ft. from W. Line

MISCELLANEOUS

Location

Rig up

Drilling and Remarks:

Vista 3100
5" @ 3097
Pump 50 Pst

36° Gr

RECORD

Cased in., ft.

Sand

Gas

Oil

Total Depth 3102

PRODUCTION

1st 24 hrs. Nat.

1st 24 hrs. after shot

Gas Cu. Ft.

Dry Hole

Abandoned

Date

MAY 27 1941

19

S. J. LEWIS Scout