


Section 6 Township 27 Range 6E

Well No. #1 Doughty

Company H & M Drlg.

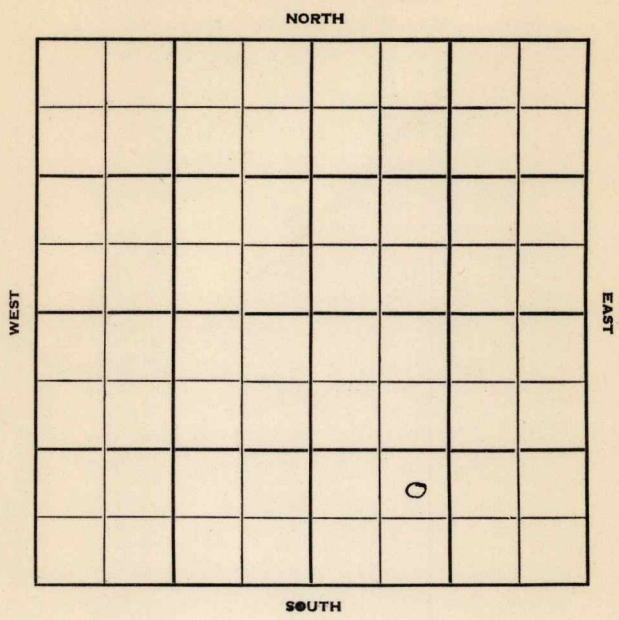

Butler

KANON

Sec. 6 Twp. 27 R. 6E ✓

Well No. #1 Doughty Farm

H & M Drlg. Company

H & M Drlg. - Contr. Contractor

Garden


..... Ft. from N. Line

990' Ft. from S. Line

..... Ft. from E. Line

990' Ft. from W. Line

NE SW SE

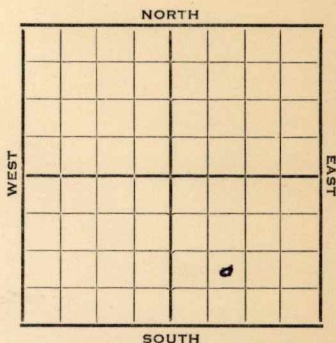

1952

Elev. 1343'

REPORT

1/30

MIR

2/6

Drlg. 2662'

2/13

Miss 2738 TD 3088

5" @ 3088

3/5

Spud 1-31-52

Oil Well TD 3100

8" @ 65

Bart 2703

Miss 2738

TD 3088 5" @ 3088 **Viola 3097**

DD 3100 S/ 20 bo 200 bw 24 hr.

Comp. 15 bopd & lots of wtr.

COMPLETED

