


Butler

KANSAS

Section 6 Township 27 Range 6-E

Well No. 5 - Doughty

Company Mohawk

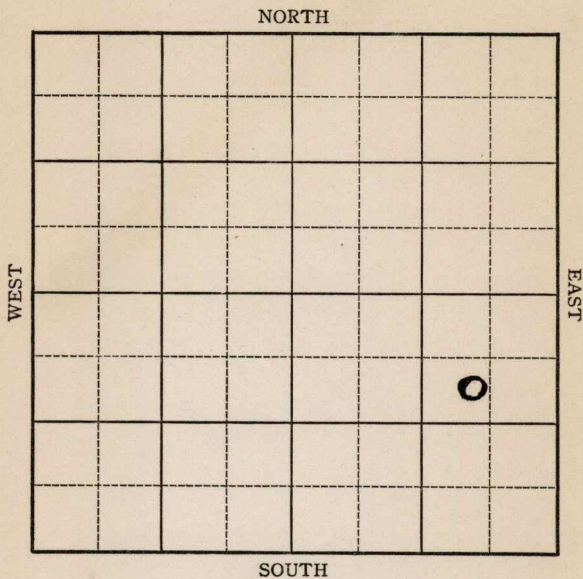

Sec. 6 Twp. 27 R. 6-E


Well No. #5 Doughty Farm  
Mohawk Company

990 Ft. from N. Line

\_\_\_\_\_ Ft. from S. Line

760 Ft. from E. Line

\_\_\_\_\_ Ft. from W. Line

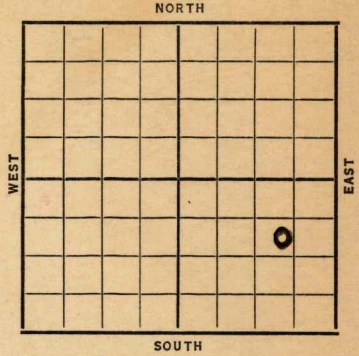

Date

REPORT

1937

7/28

12" @ 810'

10" @ 1440'

Miss 2744'

Viola 3104'

TD 3108½'

5" @ 3072'

500 acid

Pot 35 oi & 35 water per day.

**FIRST REPORT**

*and*

**COMPLETED**

Butler KANSAS

Map No. 11 Sec. 6 Twp. 27 R. 6E

Well No. 5-Doughty

Mohawk Company

Contractor

FIRST REPORT

COMPLETED

SECTION PLAT

990 Ft. from N. Line

\_\_\_\_\_ Ft. from S. Line

760 Ft. from E. Line

\_\_\_\_\_ Ft. from W. Line

			0

Location \_\_\_\_\_

Rig up \_\_\_\_\_

Drilling and Remarks:

12" - 810

10" - 1440

Miss 2744

Viol 3104

T.O. 3108 1/2

5" - 3072

500 Acid

RECORD

Cased \_\_\_\_\_ in., \_\_\_\_\_ ft.

Sand \_\_\_\_\_

Gas \_\_\_\_\_

Oil \_\_\_\_\_

Total Depth \_\_\_\_\_

PRODUCTION

1st 24 hrs. Nat. \_\_\_\_\_

1st 24 hrs. after shot \_\_\_\_\_

Gas \_\_\_\_\_ Cu. Ft.

Dry Hole \_\_\_\_\_

Abandoned \_\_\_\_\_

Put 35 oil & 35 water per day

Date

JUL 28 1937 19

H. D. Hatfield

Scout