


M^cPherson

Form 51-5M-11-31-Palace

Map No. **KANSAS** Sec. 20 Twp. 19 R. 12W

Well No. 1-Coons Farm _____
Darby Pet Co Company _____

NORTH

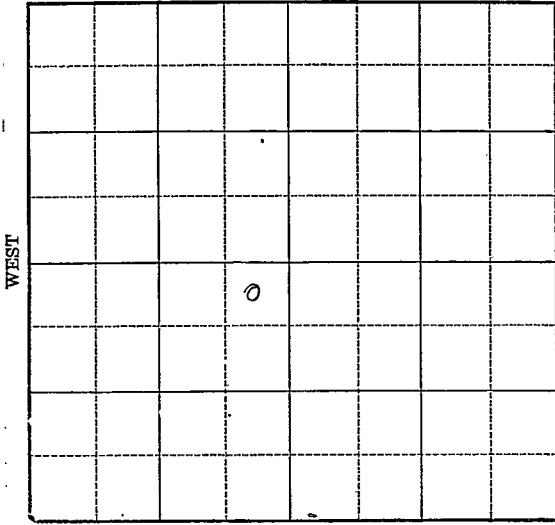

Location _____

Drilling Remarks _____

Rig Up _____

Drilling Remarks _____

RECORD

Cased _____ in. _____ ft.
Sand _____
Gas _____
Oil _____
Total Depth _____

PRODUCTION

1st 24 hrs. Nat. _____
1st 24 hrs. after shot _____
Gas _____ cu. ft. _____
Dry Hole _____
Abandoned _____


Map No. KANSAS Sec. 20 Twp. 19 R. 1^w
Well No. 1-Coons Farm
Warby Pet Company

330 Ft. from N. Line

_____ Ft. from S. Line

330 Ft. from E. Line

_____ Ft. from W. Line

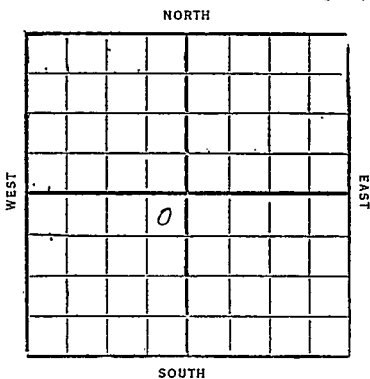

1932

Date	REPORT
2/17	Loc
2/26	
3/2	Culvert
3/9	R.O.S.
3/16	
3/22	Rotary rig
3/30	
4/6	20"-118
4/13	Dreg 2000'
4/20	" 2915'
4/27	Top Chat 2962
5/4	Dreg 3412 3413
5/11	Top Viola 3410 3413
	Cem 6"- Rust
	Top Viola 3413' (corrected)
	Had 1950 ft oil in
	2 1/2 hrs bit 3419
	T.D. 3423
	swab 31 bbls per hr
	for 17 hours

(over)

5/18- T.D. 3427
shot 20 qt 3417-27
swab 35 bbl per hour

5/25- T.D. 3427 Yes test

6/11- T.D. 3427
Pump 32 bbl per hr

6/18- T.D. 3427 No test

6/15- Viola 3413-27
T.D. 3427
shot 20 qt 3417-27
Potential prod
Pump 1234 bbl 24 hr
Comp

McPherson

43 KANSAS

Map No. _____ Sec. 20 Twp. 19 R. 1 ^W

Well No. 1 *Coons*

Darby Pet Co Company

Contractor

FIRST REPORTS

330 Ft. from N. Line

_____ Ft. from S. Line

330 Ft. from E. Line

_____ Ft. from W. Line

SECTION PLAT

	o	.	

Location

Rig up _____

Drilling and Remarks:

RECORD

Cased _____ in., _____ ft.

Sand _____

Gas _____

Oil _____

Total Depth _____

PRODUCTION

1st 24 hrs. Nat. _____

1st 24 hrs. after shot _____

Gas _____ Cu. Ft.

Dry Hole _____

Abandoned _____

Date

FEB 17 1932

CHAS. L. SHERWOOD

Scout

McPherson

43 KANSAS Map No. Sec. 20 Twp. 19 R. 1 W

Well No. 1 Corner

Darby Petroleum Company

Contractor

COMPLETED

SECTION PLAT

330 Ft. from N. Line
Ft. from S. Line
330 Ft. from E. Line
Ft. from W. Line

	0		

Location

Rig up

Drilling and Remarks:

Shot 20/3417-27

*Potential prod
1234 Bbls in
24 hours on pump*

RECORD

Cased in. ft.
Sand *Viola 3413-3427*
Gas
Oil
Total Depth *3427*

PRODUCTION

1st 24 hrs. Nat.
1st 24 hrs. after shot
Gas Cu. Ft.
Dry Hole
Abandoned

Date

JUN 15 1932

CHAS. L. SHERWOOD