


Map No. KANSAS Sec. 20 Twp. 19 R. 1W
 Well No. 1 - Gauge Farm
United Oil & Shell Company

NORTH Darby Pet. & Shell

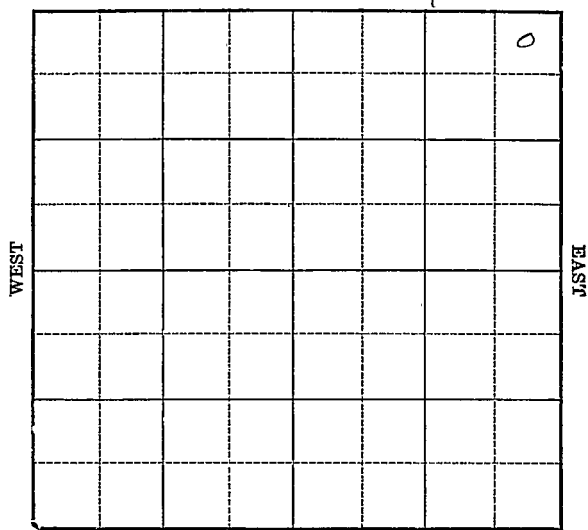

SOUTH

OWDD

Location _____
 Drilling Remarks _____

Rig Up _____
 Drilling Remarks _____

RECORD

Cased _____ in. _____ ft.
 Sand _____
 Gas _____
 Oil _____
 Total Depth _____

PRODUCTION

1st 24 hrs. Nat. _____
 1st 24 hrs. after shot _____
 Gas _____ cu. ft.
 Dry Hole _____
 Abandoned _____

Map No. KANSAS Sec. 20 Twp. 19 R. 1^W

Well No. 1- Kalg Farm

~~United Oil & Shell~~ Company

Darby Pet. & Shell NORTH


330 Ft. from N. Line

_____ Ft. from S. Line

330 Ft. from E. Line

_____ Ft. from W. Line

1930

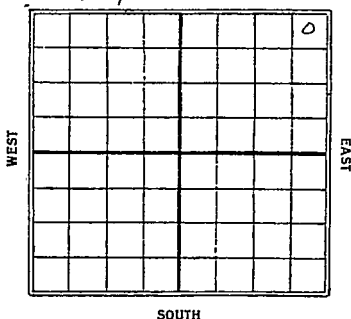

Date

REPORT

10/22	Loc
10/29	Pond
11/5	
11/12	Rig
11/19	Stud
11/25	Walg 570'
12/3	" 1150'
12/10	Run 12"-1345
12/17	Show oil & HFW at 1610
	Walg 1650
12/23	SD 1670'
12/30	Walg 2650
1931	
1/7	SD 2650'
1/14	
1/21	Ralg 2800'
1/28	16"-2910
	Chat 2912
	Show gas 2912-14
	Walg ahead
	(over)

2/4 - Top Chat 2917' (SLM)
 1st gas 2932-35'
 P.B.P.
 2/11 - Chat 2917-55
 TD 2955
 14 ft gas
 Comp
 1932 **OWDD**
 6/8 - Old TD 2955
 Bldg rig to deeper
 6/15 —
 6/22 —
 6/29 - SD 2970'
 7/6 —
 7/13 —
 7/20 - TD 2970' Rgn rotary
 7/27 - Coring at 3363'
 8/3 - Top Viola 3375
 5" - 3376 Rust.
 8/10 - dreg cement 3376.
 8/17 - TD 3385
 swab 237½ bbl 13 hrs
 8/24 - TD 3385' No test
 8/31 - TD 3385
 Pump 582 bbl 24 hr
 Taking potential
 9/7 —
 9/14 —
 9/21 - Cased 5" - 3376
 Viola 3375-85
 TD 3385
 Comp Potential prod
 Pump 582 bbl.

W. H. Henson
 Map No. **KANSAS** Sec. 20 Twp. 19 R. 14

43
 Well No. 1 Haegei

United Petroleum & Shell Company

Contractor


SECTION PLAT

330 Ft. from N. Line

..... Ft. from S. Line

330 Ft. from E. Line

..... Ft. from W. Line

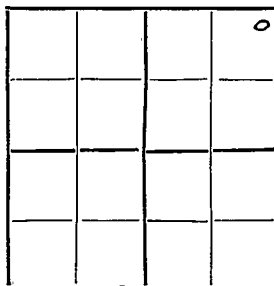

FIRST REPORTS

Location.....

Rig up.....

Drilling and Remarks:

RECORD

Cased.....in.,ft.

Sand.....

Gas.....

Oil.....

Total Depth.....

PRODUCTION

1st 24 hrs. Nat.....

1st 24 hrs. after shot.....

Gas.....Cu. Ft.

Dry Hole.....

Abandoned.....

Date

OCT 22 1935

S. J. LEWIS

Scout

Map No. KANCAE Sec. 20 Twp. 19 R. 1W

Well No. 1 Taegi

United Oil & Shell Company

Contractor

SECTION PLAT

			0

330 Ft. from N. Line

..... Ft. from S. Line

330 Ft. from E. Line

..... Ft. from W. Line

COMPLETED

Location.....

Rig up.....

Drilling and Remarks:

RECORD

Cased..... in., ft.

Sand 2917-55

Gas 14-11

Oil.....

Total Depth 2955

PRODUCTION

1st 24 hrs. Nat.....

1st 24 hrs. after shot.....

Gas..... Cu. Ft.

Dry Hole.....

Abandoned.....

Date

FEB 1 1 1931

192

Scout

McPherson

43 KANSAS

Map No. _____ Sec. 20 Twp. 19 R. 1

Well No. 1 Kaeji

Darby Oil Co & Shell Company

Contractor

FIRST REPORTS

330 Ft. from N. Line

Ft. from S. Line

330 Ft. from E. Line

Ft. from W. Line

SECTION PLAT

			0
	"		"
	OWD		
	!		

Pres reported as finished & Shell

Location _____

Rig up _____

Drilling and Remarks:

Blag Rig to Depth

RECORD

Cased 3 in. _____ ft.

Sand Chas 2917-55

Gas 1.4 14

Oil _____

Total Depth 2955

PRODUCTION

1st 24 hrs. Nat. _____

1st 24 hrs. after shot _____

Gas _____ Cu. Ft.

Dry Hole _____

Abandoned _____

Date

JUN 8 1932

CHAS. L. SHERWOOD

192

Scout

McPherson

43 KANSAS

W

Map No. _____ Sec. 20 Twp. 19 R. 1

Well No. 1 Kaegi

Darby Oil Co. & Shell Company

Contractor

COMPLETED

SECTION PLAT

			P

330 Ft. from N. Line

_____ Ft. from S. Line

330 Ft. from E. Line

_____ Ft. from W. Line

Location _____

Rig up _____

Drilling and Remarks:

Potential Prod

Pump 58 r Be

RECORD

Cased 5 in. 3374 ft.

Sand Viola 3375-3385

Gas _____

Oil _____

Total Depth 3385

PRODUCTION

1st 24 hrs. Nat. _____

1st 24 hrs. after shot _____

Gas _____ Cu. Ft.

Dry Hole _____

Abandoned _____

Date

SEP 2 1 1932

192

CHAS. L. SHERWOOD

Scout