


McPherson
Form 51-5M-2-29-34703
Map No. **KANSAS** Sec. *20* Twp. *19* R. *1w*
Well No. *1-McPherson* Farm
United Oil & Gypsum Company
NORTH

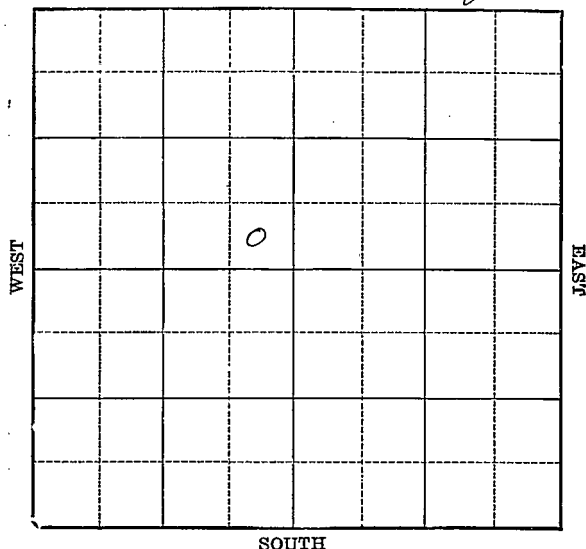

Location _____

Drilling Remarks _____

Rig Up _____

Drilling Remarks _____

RECORD

Cased _____ in. _____ ft.

Sand _____

Gas _____

Oil _____

Total Depth _____

PRODUCTION

1st 24 hrs. Nat. _____

1st 24 hrs. after shot _____

Gas _____ cu. ft.

Dry Hole _____

Abandoned _____

Map No. KANSAS Sec. 20 Twp. 19 R. 1^W

Well No. 1- M^o Hill Farm

United Petro Supply Company
et al


 Ft. from N. Line

330 Ft. from S. Line

330 Ft. from E. Line

 Ft. from W. Line

1931

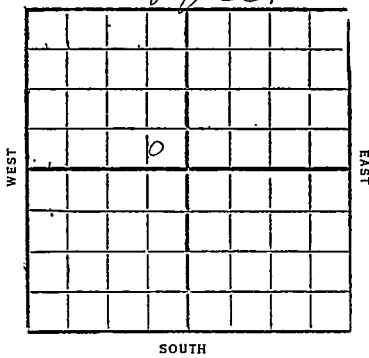

Date

REPORT

8/12	Loc
8/19	Blkg rug
8/26	1000
9/2	Spdg.
9/9	15"- 451
	Drlg 540'
9/16	" 1485
9/23	SD 1925'
9/30	HFW 2145
	Drlg 2150'
10/7	10"- 2270
	Drlg 2275'
10/14	" 2595'
10/21	" 2875'
10/28	Top Chat 2948
	T.D. 2950
	show oil & gas
	Cem & csq
11/4	First show 2988
	T.D. 2994
	1 1/2 ft gas and
	flow 4 bbl per hour

11/10 - Some water 3008-12
drlg ahead
11/18 - " 3068'
11/24 - SD 3068'
12/2 -
12/19 - Drlg 3120'
12/16 - " 3183
12/22 - TD 3183 VIR 6"
12/30 - Base - me 3160
drlg 3290'
1932
1/6 - Viola ³⁴⁰⁹⁻²²~~3416-28~~
2200' oil in 2 hours
1/13 - TD ~~3428~~ No test
1/20 -
1/27 -
2/3 - TD ~~3428~~ 3422
swab 1000 bbl 36 hrs
2/10 - T.D. ~~3428~~³⁴²² Cld out
2/17 - Top Viola 3409 (corrected)
T.D. 3422
P.B to 3421
shot 10 qt 3416-21
swab 25 bbl per hour
2/26 swab 40 " " "
for 4 hours and
swab 30 bbl per hr
for 2 hours
3/2 - swab 337 bbl 9 hrs
800' off bottom
swabbing & Cld out


Map No. Kamp Sec. 20 Twp. 19 R. 1^W
 Well No. 1- M^c Gill Farm
United Oil & Gypsum Company
 NORTH

 Ft. from N. Line

330 Ft. from S. Line

330 Ft. from E. Line

 Ft. from W. Line

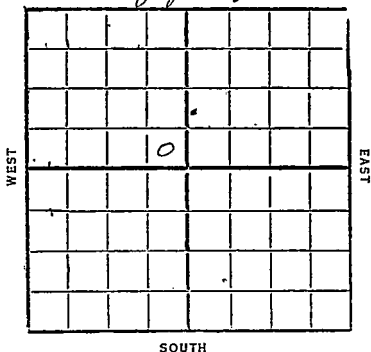

1932

Date

REPORT

3/9 Top Viola 3409
 T.D. 3422
 P.B. to 3421
 Shot 17 qt 3423-28
 Oil out
 3/16 swab 45 bbl per hour
 3/22 No test
 3/30 —
 4/16 T.D. 3421
 Shot 17 qt 3423-28
 Rng tubing
 4/13 —
 4/20 T.D. 3421
 Prep to pump.
 4/27 T.D. 3421
 Pump 60 bbl per hr
 5/4 Viola 3409-3422
 T.D. 3422
 P.B. to 3421
 Shot 10 qt 3416-21
 Potential prod
 1368 bbl oil
 Comp.

McPherson

W

KANSAS

Map No. _____ Sec. 20 Twp. 19 R. 1

Well No. 43 Mc Gie

United Pet- Gypsum Co Company

Contractor

FIRST REPORTS


_____ Ft. from N. Line

330 Ft. from S. Line

330 Ft. from E. Line

_____ Ft. from W. Line

SECTION PLAT

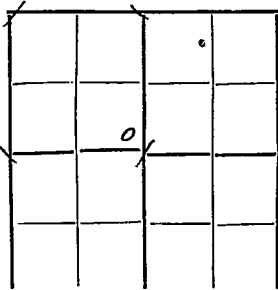

Location ✓

Rig up

Drilling and Remarks:

RECORD

Cased _____ in., _____ ft.

Sand _____

Gas _____

Oil _____

Total Depth _____

PRODUCTION

1st 24 hrs. Nat. _____

1st 24 hrs. after shot _____

Gas _____ Cu. Ft.

Dry Hole _____

Abandoned _____

Date

AUG 1 2 1931

CHAS. L. SHERWOOD

192

Scout

43 KANSAS

Map No. _____ Sec. 20 Twp. 19 R. 1

Well No. 1 Mc Gill

United Petroleum & Gypsum Co. #1 Company

Contractor

COMPLETED

SECTION PLAT

_____ Ft. from N. Line

330 Ft. from S. Line

330 Ft. from E. Line

_____ Ft. from W. Line

Location _____

Rig up _____

Drilling and Remarks:

PB 3421

Shot 10/3416-21

Patented Prod

1368 Bbs.

RECORD

Cased _____ in. _____ ft.

Sand Viola 3409-3422

Gas _____

Oil _____

Total Depth 3422

PRODUCTION

1st 24 hrs. Nat. _____

1st 24 hrs. after shot _____

Gas _____ Cu. Ft.

Dry Hole _____

Abandoned _____

Date

MAY 4 1932 CHAS. L. SHERWOOD

192 _____ Scout