


Map No. 2 Kans Sec. 7 Twp. 32 R. 5

Well No. 1 Cratsley Farm  
Ark Fuel Company

NORTH

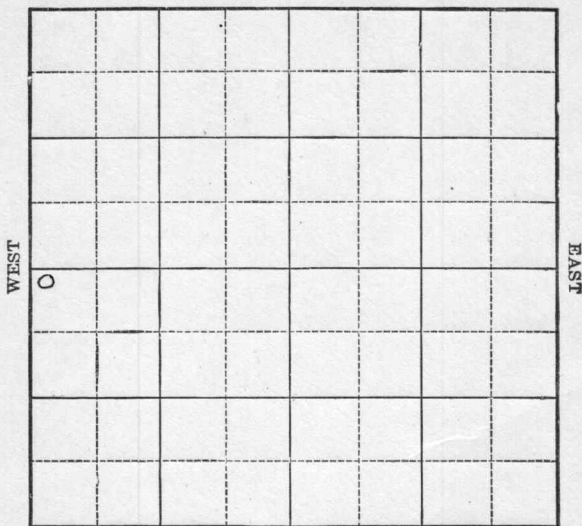

SOUTH

Location \_\_\_\_\_

Rig Up \_\_\_\_\_

Drilling Remarks:

Drilling Remarks:

\_\_\_\_\_  
 \_\_\_\_\_  
RECORD

PRODUCTION

Cased \_\_\_\_\_ in. \_\_\_\_\_ ft.

1st 24 hrs. Nat. \_\_\_\_\_

Sand \_\_\_\_\_

1st 24 hrs. after shot \_\_\_\_\_

Gas \_\_\_\_\_

Gas \_\_\_\_\_ cu. ft.

Oil \_\_\_\_\_

Dry Hole \_\_\_\_\_


Total Depth \_\_\_\_\_

Abandoned \_\_\_\_\_

Map No. K Sec. 7 Twp. 32 R. 5

Well No. 1 Eratsley Farm  
Ark. Fuel Company

300 Ft. from N. Line  
 \_\_\_\_\_ Ft. from S. Line  
 \_\_\_\_\_ Ft. from E. Line  
300 Ft. from W. Line

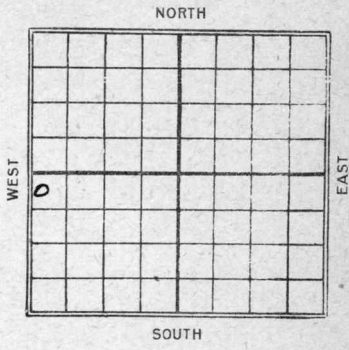

C.

Date	REPORT
1924	
9/23	Timbers
11/26	Rig
12/17	Dely 450'
1925	
1/21	S.D. 660
5/29	Setting 5" @ 3514
6/5	Dely 3525
6/19	✓ 3613
6/26	✓ 3680
7/3	Rep Boiler 3702
7/10	T.D. 3740 sho of 3090-92
	✓ ✓ --- 3304-06
	good sho - --- 3488-90
	Water 3525 D + Aluf

Map No. *2 Kans* Sec. *7* Twp. *32* R. *5*

Well No. *1 Cratsley*

*Ark Fund* Company

Contractor

FIRST REPORTS

SECTION PLAT

*300* Ft. from N. Line  
Ft. from S. Line  
Ft. from E. Line  
*300* Ft. from W. Line

<i>0</i>			

Location  
Rig up  
Drilling and Remarks:

*Timbers*

RECORD

Cased \_\_\_\_\_ in., \_\_\_\_\_ ft.  
Sand \_\_\_\_\_  
Gas \_\_\_\_\_  
Oil \_\_\_\_\_  
Total Depth \_\_\_\_\_

PRODUCTION

1st 24 hrs. Nat. \_\_\_\_\_  
1st 24 hrs. after shot \_\_\_\_\_  
Gas \_\_\_\_\_ Cu. Ft.  
Dry Hole \_\_\_\_\_  
Abandoned \_\_\_\_\_

Date

*7/23* 192 *4* *MAB.* Scout




Contractor

COMPLETED

SECTION PLAT

300 Ft. from N. Line

----- Ft. from S. Line

----- Ft. from E. Line

300 Ft. from W. Line

<u>3</u>			

ABANDONED

Location -----

Rig up -----

Drilling and Remarks:

Show oil 2 3090-92'  
3304-06'  
good show 3488-90'  
water 3525'  
dry & abandoned  
3740'

RECORD

Cased ----- in., ----- ft.

Sand -----

Gas -----

Oil -----

Total Depth 3740'

PRODUCTION

1st 24 hrs. Nat. -----

1st 24 hrs. after shot -----

Gas ----- Cu. Ft.

Dry Hole

Abandoned

Date

JUL 10 1925

CHAS. L. SHERWOOD

Scout

192