


McPherson

Form 51-5M-11-31-Palace

Map No. **KANSAS** Sec. *20* Twp. *19* R. *12W*

Well No. *2* *Logument* Farm
Perby et al. Company

NORTH

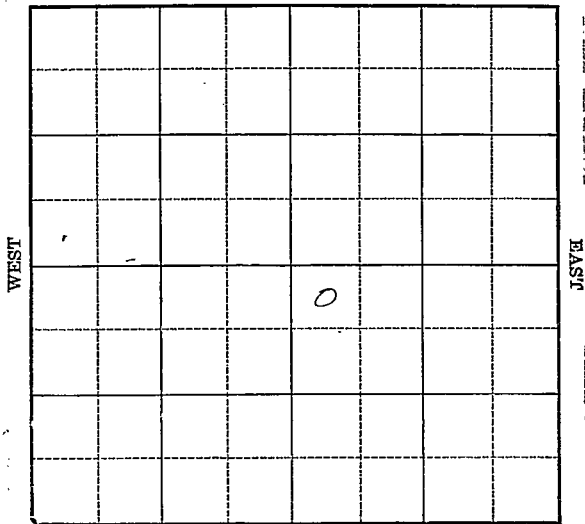

SOUTH

Location _____

Drilling Remarks _____

Rig Up _____

Drilling Remarks _____

RECORD

Cased _____ in. _____ ft.
Sand _____
Gas _____
Oil _____
Total Depth _____

PRODUCTION

1st 24 hrs. Nat. _____
1st 24 hrs. after shot _____
Gas _____ cu. ft. _____
Dry Hole _____
Abandoned _____

Map No. KANSAS Sec. 20 Twp. 19 R. 12W


Well No. 2-Logument Farm
Durby Oil Company

330 Ft. from N. Line

_____ Ft. from S. Line

_____ Ft. from E. Line

330 Ft. from W. Line

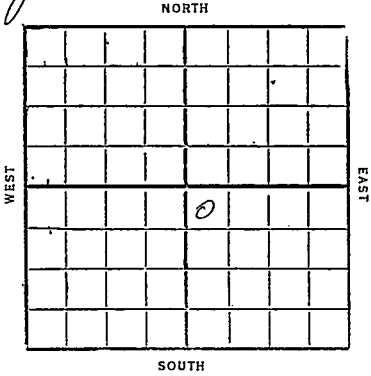

1932

Date	REPORT
2/17	Loc
2/26	
3/2	Bldg. rig
3/9	Run up
3/16	Drg 1650'
3/22	" 2780'
3/30	Top Chat 2942 Drg 3150'
4/6	Rem 8" - 3360 S/R at 3400'
4/13	Viola 3401-12 Oil 3404
	Increase oil 3406-09 T.D. 3412
	Shot 10 qt 3404-12 swab 60 bbl first haul
	" 42 " second "
	" 41 " third "
	Clg out
4/20	T.D. 3412
	Ry. to pump
	(over)

4/27-

Cased 8" 3360

Viola 3401-12

TD 3412

shot 10 qt 3404-12

1582 bbls oil

potential prod.
Comp.

McPherson

43

KANSAS

Map No. _____ Sec. *20* Twp. *19* R. *1* ^W

Well No. *2 Lacquement*

Derby et al Company

Contractor

FIRST REPORTS

330 Ft. from N. Line

_____ Ft. from S. Line

_____ Ft. from E. Line

330 Ft. from W. Line

SECTION PLAT

		o	

Location

Rig up _____

Drilling and Remarks:

1700-1811

RECORD

Cased _____ in., _____ ft.

Sand _____

Gas _____

Oil _____

Total Depth _____

PRODUCTION

1st 24 hrs. Nat. _____

1st 24 hrs. after shot _____

Gas _____ Cu. Ft.

Dry Hole _____

Abandoned _____

Date

FEB 17 1932

19

CHAS L. SHERWOOD

Scout

McPherson

W

43
Map No. **KANSAS** Sec. *20* Twp. *19* R. *1*

Well No. *2 Locumment*

Derby Oil Company

Contractor

COMPLETED

SECTION PLAT

330 Ft. from N. Line

..... Ft. from S. Line

..... Ft. from E. Line

330 Ft. from W. Line

		<i>σ</i>	

Location.....

Rig up.....

Drilling and Remarks:

Shot 10/3404-12

*Potential Prod
1582 Bls.*

RECORD

Cased *8* in., *3360* ft.

Sand *Viola 3401-3412*

Gas.....

Oil.....

Total Depth *3412*

PRODUCTION

1st 24 hrs. Nat.....

1st 24 hrs. after shot.....

Gas..... Cu. Ft.

Dry Hole.....

Abandoned.....

Date

APR 27 1932 **CHAS. L. SHERWOOD**

192

Scout