


Mc Pherson

Form 51-5M-11-31-Palace

Map No. **KANSAS** Sec. 20 Twp. 19 R. 1^W

Well No. 2 Mc Gill Farm

J C Johnson & Gypsum Company

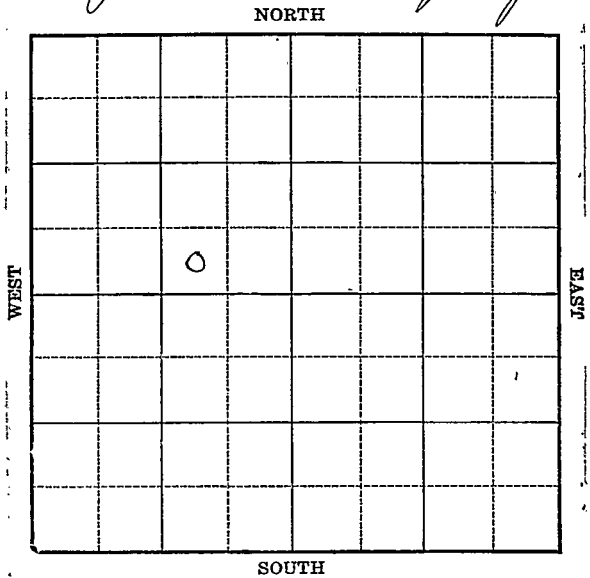

Location _____

Drilling Remarks _____

Rig Up _____

Drilling Remarks _____

RECORD

Cased _____ in. _____ ft.

Sand _____

Gas _____

Oil _____

Total Depth _____

PRODUCTION

1st 24 hrs. Nat. _____

1st 24 hrs. after shot _____

Gas _____ cu. ft. _____

Dry Hole _____

Abandoned _____

McPherson


KANSAS

Map No. _____ Sec. 20 Twp 19 R. 1W

Well No. 2 Mc Gill Farm _____

J.C. Johnson - Gypsy Company _____

_____ Ft. from N. Line
330 Ft. from S. Line
990 Ft. from E. Line
_____ Ft. from W. Line

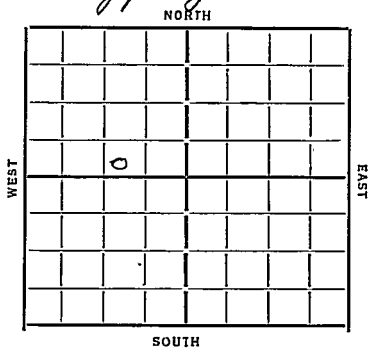

Date
1934

REPORT

1/17 location
1/24 R.O. 4.
1/31 Building Rig
2/7 Rigging up
2/14 Drilg 495
2/23 " 1035
3/1 " 1620 219 92 1350
3/8 " 2230 10" 1960 217W 2135
3/15 10" at 2219 21R 10" at 2227
3/22 Drilg 2610 10" 2292
3/29 Chat. 2939 8" 2940
4/5 Chat Corrected 2931
Oil flowing by heads
3010 Drilg 3075
4/12 Viola 3411 TD 3422 900'
oil Will acidize
4/19 187 oil 5 Water 24 hrs Pump
4/26 203 Bbls 24 hrs May deepen
5/2 Viola 3411 TD 3475
Pump 203 Bbls.

COMPLETED

Map No. 43 Sec. 20 Twp. 19 R. 1W

Well No. 2 - McMill

T. C. Johnson & Company Contractor

FIRST REPORTS

..... Ft. from N. Line
330 Ft. from S. Line
990 Ft. from E. Line
..... Ft. from W. Line

SECTION PLAT

	0		

Location ✓
Rig up.....
Drilling and Remarks:

RECORD

Cased..... in., ft.
Sand.....
Gas.....
Oil.....
Total Depth.....

PRODUCTION

1st 24 hrs. Nat.....
1st 24 hrs. after shot.....
Gas..... Cu. Ft.
Dry Hole.....
Abandoned.....

Date

1-17-34 192 O. Manschreck Scout

