

Map No. _____ Sec. 6 Twp. 27 R. 6

Well No. 1 Haver Farm
Okla Pet Company

NORTH

WEST

EAST

SOUTH

Location -----

Drilling Remarks:

Rig Up-----

Drilling Remarks:

RECORD

Cased _____ in _____ Ft.
 Sand _____
 Gas _____
 Oil _____
 Total Depth _____

PRODUCTION


1st 24 hrs. Nat-----
1st 24 hrs. after shot-----
Gas-----Cu. Ft.
Dry Hole-----
Abandoned -----

Map No. K11 Sec. 6 Twp. 27 R. 6Well No. 1 Haver FarmOkla Pet. Company

NORTH

WEST

EAST

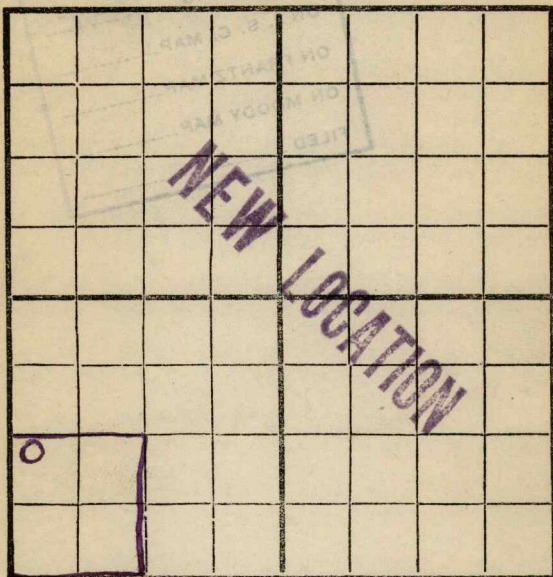

SOUTH

Location.....

Rig Up.....

Drilling and remarks

Rig up

○

RECORD

Cased..... in. Ft.

Sand.....

Gas.....

Oil.....

Total Depth.....

PRODUCTION

1st 24 hrs. Nat.

First 24 hrs. after shot.....

Gas..... Cu. Ft.

Dry Hole.....

Abandoned.....

Date

APR 21 1917

191

C. T. Crocker


Scout

Map No. _____ Sec. 6 Twp. 27 R. 6
 Well No. 1 Haven Farm _____
Okla Pet. Company _____

NORTH

WEST

EAST

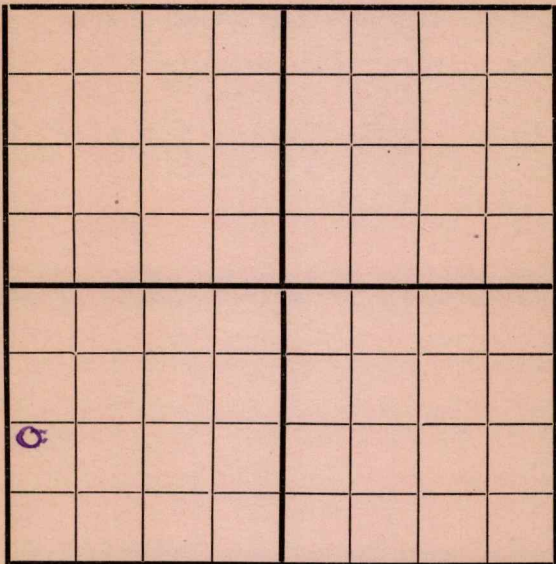

SOUTH

Location _____
 Rig Up _____
 Drilling and remarks _____

RECORD

Cased _____ in. _____ Ft.
 Sand _____
 Gas _____
 Oil _____
 Total Depth _____

PRODUCTION

1st 24 hrs. Nat. _____
 1st 24 hrs. after shot _____
 Gas _____ Cu. Ft.
 Dry Hole _____
 Abandoned _____

Date


4/28, 1917 Durker Scout

Map No. K11 Sec. 6 Twp. 27 R. 6Well No. 1 Therese Farm
Ole Petro Company

NORTH

WEST

EAST

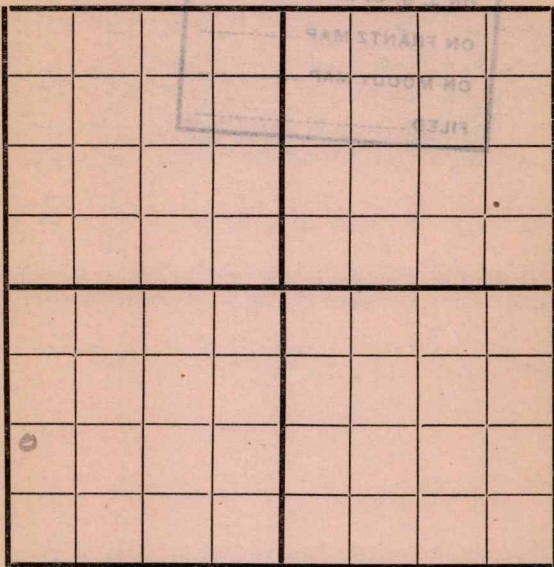

SOUTH

Location _____

Rig Up _____

Drilling and remarks

Rigged up

RECORD

Cased _____ in. _____ Ft.

Sand _____

Gas _____

Oil _____

Total Depth _____

PRODUCTION

1st 24 hrs. Nat. _____

1st 24 hrs. after shot _____

Gas _____ Cu. Ft.

Dry Hole _____


Abandoned _____

Date

5/2, 1912 Carly Scout

Map No. _____ Sec. 6 Twp. 27 R. 6Well No. 1 Horse Farm _____Oreco Petro Company _____

NORTH

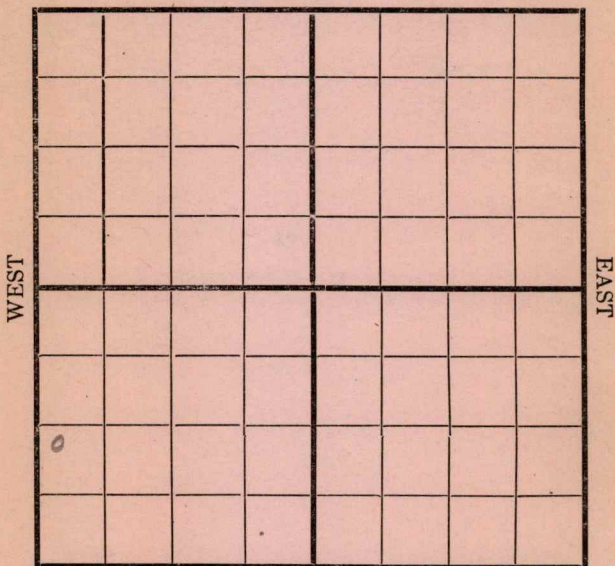

SOUTH

Location _____

Rig Up _____

Drilling and remarks

400

RECORD

Cased _____ in. _____ Ft.

Sand _____

Gas _____

Oil _____

Total Depth _____

PRODUCTION

1st 24 hrs. Nat. _____

1st 24 hrs. after shot _____

Gas _____ Cu. Ft.

Dry Hole _____


Abandoned _____

Date

5/11, 191 7 Condy Scout

Map No. _____ Sec. 6 Twp. 27 R. 6
 Well No. 1 Horse Farm _____
O. K. Petro Company _____

NORTH

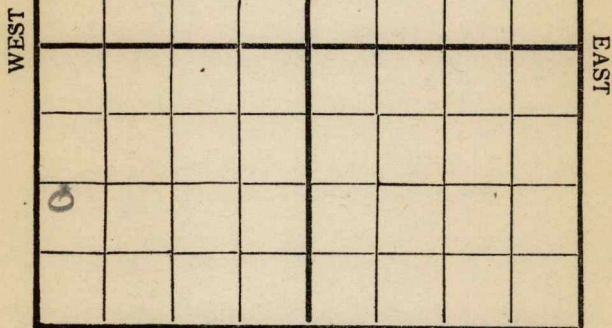

SOUTH

Location _____
 Rig Up _____
 Drilling and remarks

900'

RECORD

Cased _____ in. _____ Ft.
 Sand _____
 Gas _____
 Oil _____
 Total Depth _____

PRODUCTION


1st 24 hrs. Nat. _____
 1st 24 hrs. after shot _____
 Gas _____ Cu. Ft.
 Dry Hole _____
 Abandoned _____

Date

5/2 5-1917 Cardiff Scout

Map No. _____ Sec. 6 Twp. 27 R. 6
 Well No. 1840 Farm _____
Oker Peter Company _____

NORTH

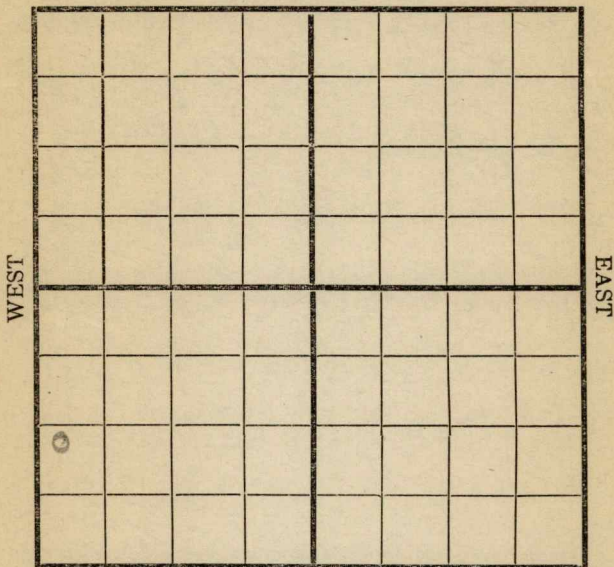

SOUTH

Location _____ Rig Up _____ Drilling and remarks <u>1840</u>	RECORD
	Cased _____ in. _____ Ft.
	Sand _____
	Gas _____
	Oil _____
	Total Depth _____
	PRODUCTION
	1st 24 hrs. Nat. _____
	1st 24 hrs. after shot _____
	Gas _____ Cu. Ft.
	Dry Hole _____
	Abandoned _____


Date 5/28, 1917 Condy Scout

Map No. _____ Sec. 6 Twp. 27 R. 6Well No. 1 Horse Farm
Okla Petro Company

NORTH

WEST

EAST

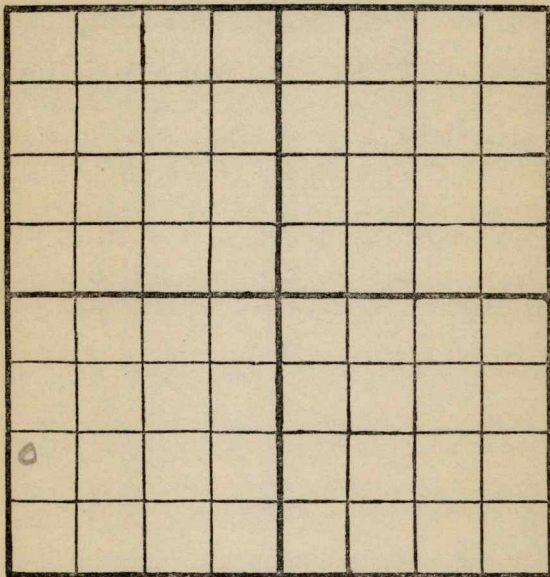

SOUTH

Location _____

Rig Up _____

Drilling and remarks

1700

RECORD

Cased _____ in. _____ Ft.

Sand _____

Gas _____

Oil _____

Total Depth _____

PRODUCTION

1st 24 hrs. Nat. _____

1st 24 hrs. after shot _____

Gas _____ Cu. Ft.

Dry Hole _____

Abandoned _____

Date


6/8, 1917, Candiff Scout

Map No. _____ Sec. 6 Twp. 27 R. 6
 Well No. 6 Moore Farm
Okla Petro Company

NORTH

WEST

EAST

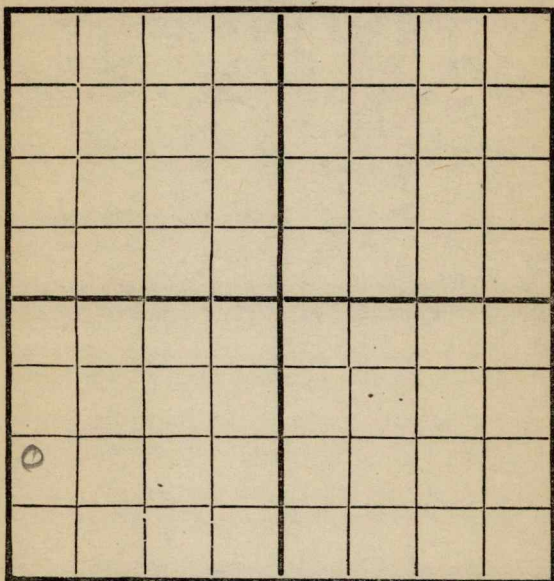

SOUTH

Location _____

Rig Up _____

Drilling and remarks

1785

RECORD

Cased _____ in. _____ Ft.

Sand _____

Gas _____

Oil _____

Total Depth _____

PRODUCTION

1st 24 hrs. Nat. _____

1st 24 hrs. after shot _____

Gas _____ Cu. Ft.

Dry Hole _____

Abandoned _____

Date


6/12, 1917, Carbide Scout

Map No. _____ Sec. 6 Twp. 27 R. 6
 Well No. 1 Honer Farm
Olsen Petro Company

NORTH

WEST

EAST

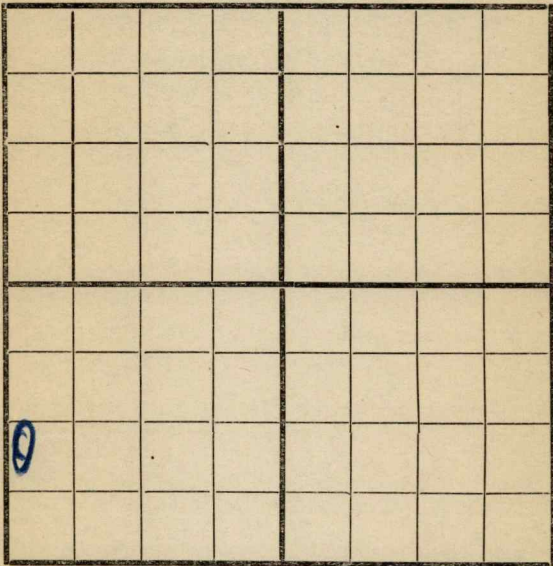

SOUTH

RECORD

Location _____
 Rig Up _____
 Drilling and remarks _____

Cased _____ in. _____ Ft.
 Sand _____
 Gas _____
 Oil _____
 Total Depth _____

PRODUCTION

1st 24 hrs. Nat. _____
 1st 24 hrs. after shot _____
 Gas _____ Cu. Ft.
 Dry Hole _____
 Abandoned _____

Date


6/20 1917 Cord Scout

Map No. _____ Sec. 6 Twp. 27 R. 6
 Well No. 12000 Farm _____
Okla Petro Company

NORTH

WEST

EAST

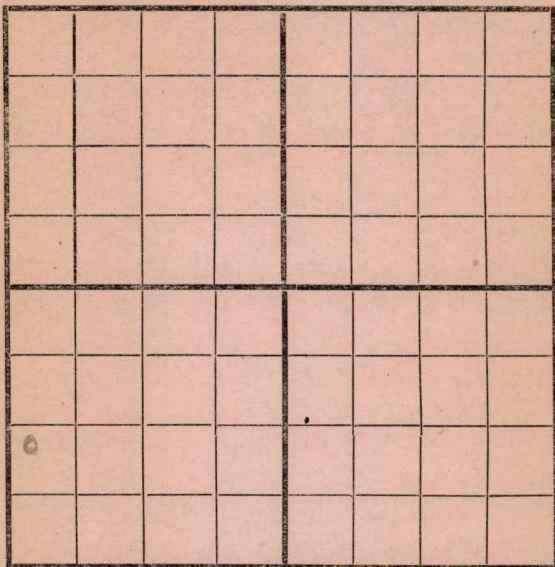

SOUTH

Location _____
 Rig Up _____
 Drilling and remarks _____

2340

RECORD

Cased _____ in. _____ Ft.
 Sand _____
 Gas _____
 Oil _____
 Total Depth _____

PRODUCTION


1st 24 hrs. Nat. _____
 1st 24 hrs. after shot _____
 Gas _____ Cu. Ft.
 Dry Hole _____
 Abandoned _____

Date

6/27 191 2 Endy Scout

Map No. _____ Sec. 6 Twp. 27 R. 6
 Well No. 1 Horan Farm _____
O. M. Petro Company _____

NORTH

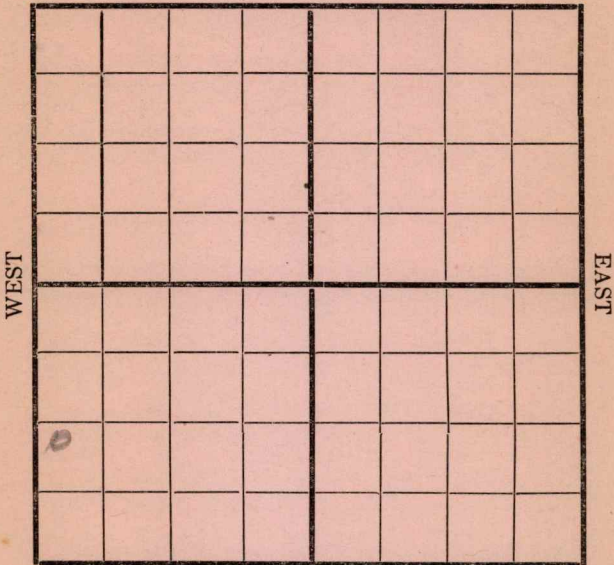

SOUTH

Location _____
 Rig Up _____
 Drilling and remarks _____

2420

RECORD

Cased _____ in. _____ Ft.
 Sand _____
 Gas _____
 Oil _____
 Total Depth _____

PRODUCTION

1st 24 hrs. Nat. _____
 1st 24 hrs. after shot _____
 Gas _____ Cu. Ft.
 Dry Hole _____
 Abandoned _____


Date

7/6, 1910 O. M. Petro Scout

Map No. _____ Sec. 6 Twp. 27 R. 6Well No. 1 _____ Farm _____
Osborne Petro Company

NORTH

WEST

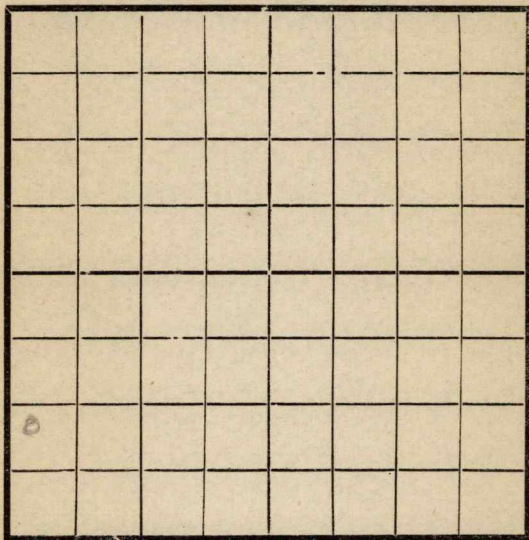

EAST

SOUTH

Location _____

Rig Up _____

Drilling and remarks

RECORD

Cased _____ in. _____ Ft.

Sand _____

Gas _____

Oil _____

Total Depth _____

PRODUCTION

1st 24 hrs. Nat. _____

1st 24 hrs. after shot _____

Gas _____ Cu. Ft.

Dry Hole _____

Abandoned _____

Date

2/2, 1912 Condy Scout

Map No. _____ Sec. 6 Twp. 27 R. 6Well No. 1740 Farm _____O. J. Peters Company

NORTH

WEST

COMPLETED

EAST

SOUTH

Location _____

Rig Up _____

Drilling and remarks _____

*Dry and
abandoned
at 2766*

RECORD

Cased _____ in. _____ Ft.

Sand 2734-2766 Dry

Gas _____

Oil _____

Total Depth _____

PRODUCTION

1st 24 hrs. Nat. _____

1st 24 hrs. after shot _____

Gas _____ Cu. Ft.

Dry Hole _____

Abandoned _____

Date

MAR 24 1917

191

C. J. Peters Scout