

Cowley

SECTION 7 TOWNSHIP 32 RANGE 5E

WELL NO. #1 Dudgeon

COMPANY O. H. Parker

NORTH

	0						

WEST

EAST

SOUTH

Cowley

KANSAS

SEC. 7	TWP. 32	R. 5E
-----------	------------	----------

WELL NO. #1 Dudgeon FARM

COMPANY O.H. Parker

CONTRACTOR


Biddle

_____ Ft. from N. Line

_____ Ft. from S. Line

_____ Ft. from E. Line

_____ Ft. from W. Line

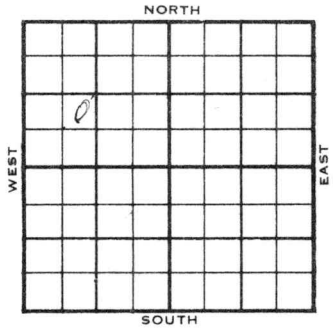

NE SW NW

1956	ELEVATION 1241'	REPORT
------	--------------------	--------

4-11 Location

5-9 Comm. 4-13-56
 8 5/8" @ 120 w/100
 5 1/2" @ 2784
 PF/ 2327-36, 2339-43, 2346-56.
 B/ 1 bwph/ trace oil, frac 2x4
 D & A

XXX ~~#####~~
 XXXX Log tops: Hoov. 2094', Lay Sd 2314'
 KC. 2452'.
 Tops Layton Sd. 2236'
 TD 2784'

ABANDONED

County Cowley Elev. 1241
 Sec. 7 Twp. 32 Rgs. 5E
 Company O. H. Parker
 Farm Name Dudgeon No. 1

TOPS	DEPTH	LOG	DATUM	Loc. in Sec.
Anh. <u>Hook</u>		<u>2094</u>		<u>NE SW NW</u>
TP. <u>Laysd</u>	<u>2326</u>	<u>2314</u>		
Tr.				
Dg.				
BL.				
L.				Geol.
K.C.		<u>2452</u>		Contr.
B.K.C.				
Ce.				
C.				
M.				Pool
M.				
K.				<u>Biddle</u>
Mz.				
Me.				
V.				
S.				
S.				
A.				
R.				
PE.				
G.				
TD.	<u>2784</u>			

Date Comm. MAY 9 1956

Location APR 18 '56 4-13 8 5/8 120, 100

1105 APR 25 '56 5 1/2 @ 2784 MAY 2 '56

PF/2327-36 PF 2339-43 1 2346-56

1 Bwph + Tr oil Frac 2x4 MAY 9 '56

DEA