


Butler

Form 51-5M-4-27-27423

Map No. **KANSAS** Sec. 6 Twp. 27 R. 6

Well No. 2-B Sluss Farm  
Garden et al Company

NORTH

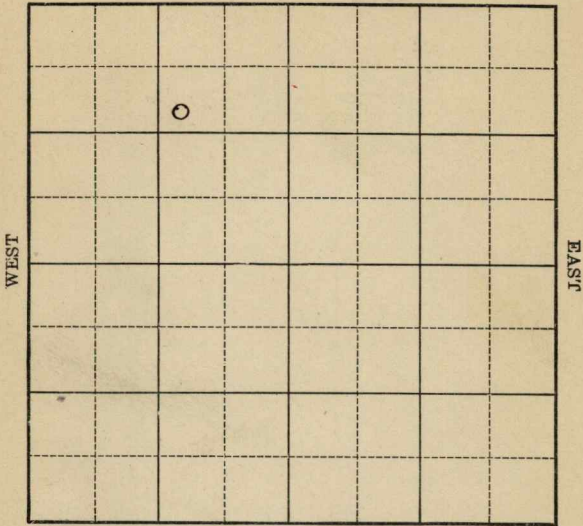

SOUTH

Location \_\_\_\_\_

Drilling Remarks \_\_\_\_\_  
\_\_\_\_\_  
\_\_\_\_\_  
Rig Up \_\_\_\_\_

Drilling Remarks \_\_\_\_\_  
\_\_\_\_\_  
\_\_\_\_\_  
**RECORD**

Cased \_\_\_\_\_ in. \_\_\_\_\_ ft.

Sand \_\_\_\_\_

Gas \_\_\_\_\_

Oil \_\_\_\_\_

Total Depth \_\_\_\_\_

**PRODUCTION**

1st 24 hrs. Nat. \_\_\_\_\_

1st 24 hrs. after shot \_\_\_\_\_


Gas \_\_\_\_\_ cu. ft.

Dry Hole \_\_\_\_\_

Abandoned \_\_\_\_\_

Map No. KANSAS Sec. 6 Twp. 27 R. 6  
 Well No. 2 B Shuss Farm  
Garden Vale Company

1120 Ft. from N. Line  
 \_\_\_\_\_ Ft. from S. Line  
1120 Ft. from E. Line  
 \_\_\_\_\_ Ft. from W. Line

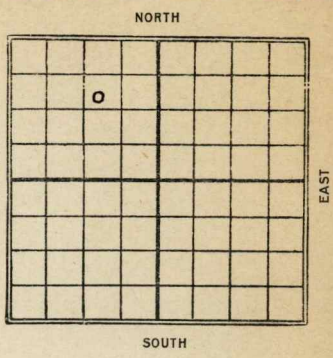

1928

Date	REPORT
9/26	Bldg.
<del>10/2</del>	<del>2 Bldg 70 80'</del>
10/3	Rig
10/10	
10/17	d Bldg 750'
10/24	" 1425'
10/31	" 2230'
" 17	sand 2724-45' Est 70 bbls Nat
" 14	Well shoot shot 80 gts - 1/2 g out
11/21	sand 2724-45' T.D. 2745 shot 80 gts 20 bbls oil Soup

Butler

K11 KANSAS MAP NO. SEC. 6 TWP. 27 R. 6

WELL NO. 22 B Suss

Sardew et al

COMPANY

CONTRACTOR

SECTION PLAT

FIRST REPORTS

	0		

1120 FT. FROM N. LINE

FT. FROM S. LINE

1120 FT. FROM E. LINE

FT. FROM W. LINE

LOCATION Blog

RIG UP

DRILLING AND REMARKS:

RECORD

CASED IN. FT.

SAND

GAS

OIL

TOTAL DEPTH

PRODUCTION

1ST 24 HRS. NAT.

1ST 24 HRS. AFTER SHOT

GAS CU. FT.

DRY HOLE

ABANDONED

DATE

SEP 26 1928

CHAS. L. SHERWOOD

192

SCOUT

*Butler*  
 K11 KANSAS MAP NO. \_\_\_\_\_ SEC. 6 TWP. 27 R. 6  
 WELL No. 2 "B" Shuss  
Sardew et al COMPANY

CONTRACTOR \_\_\_\_\_

**COMPLETED**

SECTION PLAT

	0		

1120 FT. FROM N. LINE

\_\_\_\_\_ FT. FROM S. LINE

1120 FT. FROM E. LINE

\_\_\_\_\_ FT. FROM W. LINE

LOCATION \_\_\_\_\_

RIG UP \_\_\_\_\_

DRILLING AND REMARKS:

80/20 lbs.

**RECORD**

CASED \_\_\_\_\_ IN. \_\_\_\_\_ FT.

SAND 2724-2745

GAS \_\_\_\_\_

OIL \_\_\_\_\_

TOTAL DEPTH 2745

**PRODUCTION**

1ST 24 HRS. NAT. \_\_\_\_\_

1ST 24 HRS. AFTER SHOT \_\_\_\_\_

GAS \_\_\_\_\_ CU. FT.

DRY HOLE \_\_\_\_\_

ABANDONED \_\_\_\_\_

DATE

NOV 21 1928

CHAS. L. SHERWOOD

192

SCOUT