

McPherson


KANSAS

SECTION 20 TOWNSHIP 19 RANGE 1W

WELL NO. #4 Lacquement

COMPANY Colorado O&G

NORTH

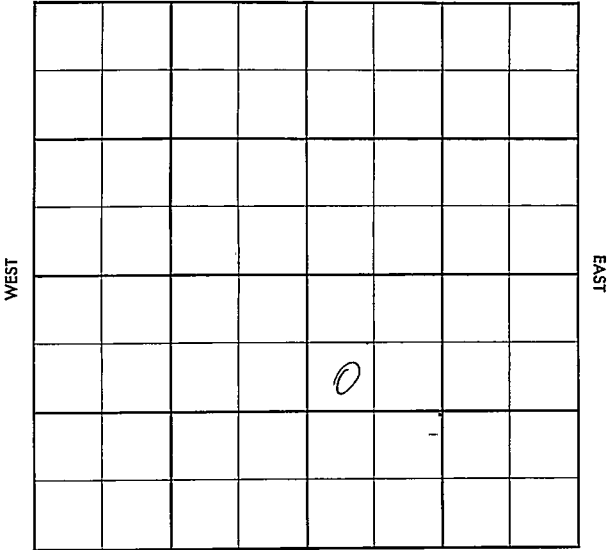

SOUTH

SEC. 20	TWP. - - 19	R. 1W
------------	----------------	----------

WELL NO.

#4 Lacquement

FARM

COMPANY

Colorado O&G

CONTRACTOR

1183 Ft. from N. Line


Ft. from S. Line

Ft. from E. Line

330 Ft. from W. Line

SW NW SE

4/2 W/2

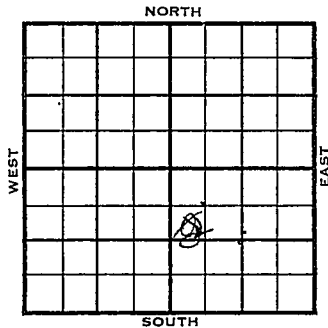

1956

ELEVATION

1575

REPORT

5-16
6-27

Location

Comm 5-26-56

8 5/8" @ 156/90 Drlg. 1165

c 3385-3402

§ 3401/175 Sx

co 3402 B 9 gal / 28 gal plt, 50 A

B 9 ga / 48 9W plt

DD 3404 tst 5 gal oil & 3 BW PH, 500A

§ 3 3/4 BO / 90 BW/ 2 hrs tst

§ 12 1/2 BO / 320 BW/12 hrs PB 3058 104/
2962-88

§ 2 BO / 3 BWPH; 4 hrs

§ 3 1/3 BO / 2 1/4 BWPH in 4 hrs PB-
2959 24/2952-58

§ 1 1/2 BO / 7 BWPH/ 12 hrs; co 3058

§ 3 BO / 10 BWPH/ 4 hrs. T&R

P. 25 BOPD / 100 BWPD

P. 36 BO / 157 BWPD

H. 2087; BL. 2274; L. 2329; M. 2924;

V. 3401

TD. 3402

COMPLETED

CORRECTION

FORM 513 SUNRAY

County McPherson Elev. 1575
 Sec. 20 Twp. 19 Rge. IW
 Company Colorado G & G
 Farm Name Lacquement No. 4

TOPS	DEPTH	LOG	DATUM
Anh.			
Ip.			
H.	2087		
Tr.			
Dg.			
Bl.	2278		
L.	2329		
K.C.			
B.K.C.			
Ce.			
C.			
M.	2924		
M.			
K.			
Mz.			
Me.			
V.	3401	3401	
S.			
A.			
R.			
Pe.			
G.			
TD.	3402		

Loc. in Sec.
 SW NW SE
 W2 W2
 183' NL
 330' WL

Geol. _____
 Contr. _____
 Pool _____

COMPLETE

Date Comm. JUN 27 '56

Location MAY 23 '56 MAY 29 '56 5.-26-56

878 156/90 ID 1165 JUN 6 '56 3395

JUN 13 '56 C 3385-3402

TD 3402 5" 3401 / 1755X

CO 3402 B 9 90 +289w PH

SO A B 9 90 +448 9W PH

DD 3404 Test 5 gal Oil +

3BW PH 500 A J

3 3/4 BO + 90 BW / shrs TX

FORM 515-1 SUNRAY 20-19-100 W/2 W/2 E

56 ♂ 12 1/2 B0 + 320 BW
in 12 hrs PB 3058 104/
2962-88 ♂ 2 B0 + 3 BWph
4 hrs ♂ 3 1/3 B0 + 2 1/4 BWph
4 hrs 1/2 ♂ 9 1/2 B0 + 38 BW
in 4 hrs PB 2959 24/2952-58
♂ 1 1/2 B0 + 7 BWph 12 hrs
CO 3058 ♂ 3 B0 + 10 BWph
4 hrs T&R JUN 27 '56 P. 25
Bopd + 100 BWpd P.
36 B0 + 157 BWpd.