


Map No. **KANSAS** Sec. 6 Twp. 27 R. 6

Well No. 3-A-Sluss Farm
Garden et al Company

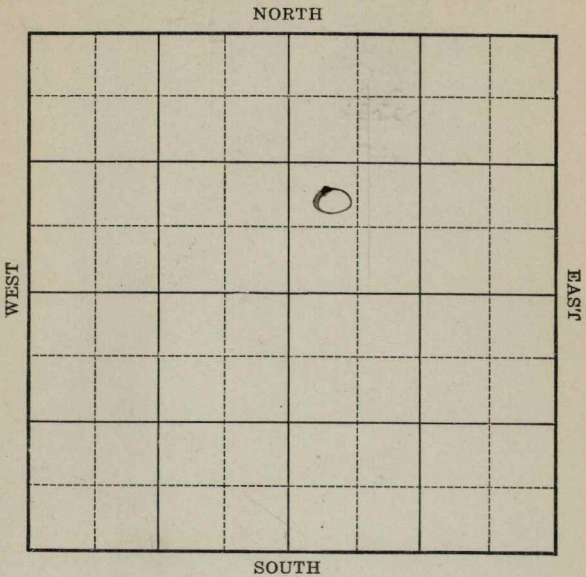

Location _____

Drilling Remarks _____

Rig Up _____

Drilling Remarks _____

RECORD

Cased _____ in. _____ ft.

Sand _____

Gas _____

Oil _____

Total Depth _____

PRODUCTION

1st 24 hrs. Nat. _____

1st 24 hrs. after shot _____

Gas _____ cu. ft.


Dry Hole _____

Abandoned _____

Map No. **KANSAS** Sec. 6 Twp. 27 R. 6

Well No. 3-A-Sluss Farm
Gardner et al Company

NORTH

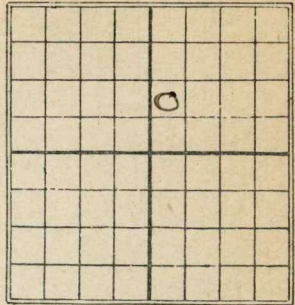

_____ Ft. from N. Line

990 Ft. from S. Line

_____ Ft. from E. Line

330 Ft. from W. Line

SOUTH

1928

Date

REPORT

Date	REPORT
<u>7/12</u>	<u>Location</u>
<u>7/19</u>	<u>Rig</u>
<u>7/26</u>	<u>Rigging up-</u>
<u>8/2</u>	<u>Drilg- 450</u>
<u>8/9</u>	<u>" 1275</u>
<u>8/16</u>	<u>" 1698 1920'</u>
<u>8/23</u>	<u>" 2140</u>
<u>8/28</u>	<u>" 2525</u>
<u>9/5</u>	<u>sand 2728-50-T.O.</u>
	<u>120/336 bbls.</u>
	<u>Comp</u>

K11

Butler

MAP NO. Kansas SEC. 6 TWP. 27 R. 6

WELL NO. 34 Shuss

Sarden et al COMPANY

CONTRACTOR

FIRST REPORTS

_____ FT. FROM N. LINE

990 FT. FROM S. LINE

_____ FT. FROM E. LINE

330 FT. FROM W. LINE

SECTION PLAT

		o	

LOCATION

RIG UP _____

DRILLING AND REMARKS:

RECORD

CASED _____ IN., _____ FT.

SAND _____

GAS _____

OIL _____

TOTAL DEPTH _____

PRODUCTION

1ST 24 HRS. NAT. _____

1ST 24 HRS. AFTER SHOT _____

GAS _____ CU. FT.

DRY HOLE _____

ABANDONED _____

DATE

7/13/28

192

Sherwood

SCOUT

K11 KANSAS

Butler

MAP No. _____ SEC. 6 TWP. 27 R. 6

WELL No. 37 Sluss

Gardner et al COMPANY

CONTRACTOR

COMPLETED

SECTION PLAT

		0	

_____ FT. FROM N. LINE

990 FT. FROM S. LINE

_____ FT. FROM E. LINE

330 FT. FROM W. LINE

RECORD

LOCATION _____

RIG UP _____

DRILLING AND REMARKS:

CASED _____ IN. _____ FT.

SAND 2728-2750

GAS _____

OIL _____

TOTAL DEPTH 2750

1207
336 Bl.

PRODUCTION

1ST 24 HRS. NAT. _____

1ST 24 HRS. AFTER SHOT _____

GAS _____ CU. FT.

DRY HOLE _____

ABANDONED _____

DATE SEP 5 1928

CHAS. L. SHERWOOD