


M^cPherson

Form 51-5M-11-31-Palace

Map No. KANSAS Sec. 20 Twp. 19 R. 1^w

Well No. 3- Locquement Farm
Derby Oil Co Company

NORTH

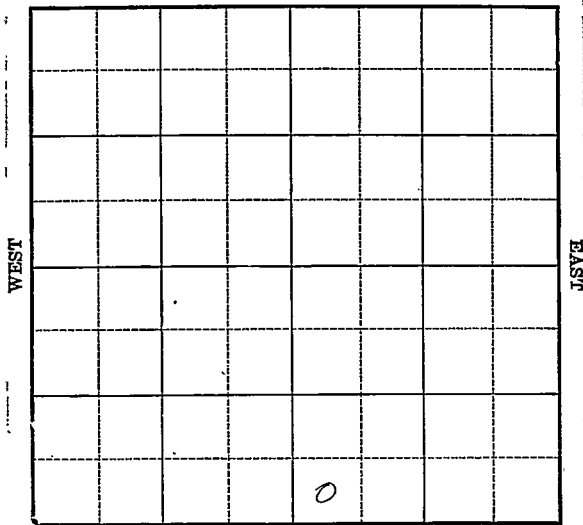

SOUTH

Location _____

Drilling Remarks _____

Rig Up _____

Drilling Remarks _____

RECORD

PRODUCTION

Cased _____ in. _____ ft.

Sand _____

Gas _____

Oil _____

Total Depth _____

1st 24 hrs. Nat. _____

1st 24 hrs. after shot _____

Gas _____ cu. ft.

Dry Hole _____

Abandoned _____

McPherson

W

43 KANSAS

Map No. _____ Sec. 20 Twp. 19 R. 1

Well No. 3 Locurement

Derby Oil Co Company

_____ Contractor

FIRST REPORTS

_____ Ft. from N. Line

330 Ft. from S. Line

_____ Ft. from E. Line

330 Ft. from W. Line

SECTION PLAT

Location

Rig up _____

Drilling and Remarks:

RECORD

Cased _____ in., _____ ft.

Sand _____

Gas _____

Oil _____

Total Depth _____

PRODUCTION

1st 24 hrs. Nat. _____

1st 24 hrs. after shot _____

Gas _____ Cu. Ft.

Dry Hole _____

Abandoned _____

Date

_____ 192 _____ Scout

McPherson

W

43 KANSAS

Map No. _____ Sec. *20* Twp. *19* R. *1*

Well No. *3* *Locame ment*

Derby Oil Co Company

Contractor

COMPLETE

_____ Ft. from N. Line

330 Ft. from S. Line

_____ Ft. from E. Line

330 Ft. from W. Line

ABANDONED

SECTION PLAT

Location _____

Rig up _____

Drilling and Remarks:

Abandoned Location

RECORD

Cased _____ in., _____ ft.

Sand _____

Gas _____

Oil _____

Total Depth _____

PRODUCTION

1st 24 hrs. Nat. _____

1st 24 hrs. after shot _____

Gas _____ Cu. Ft.

Dry Hole _____

Abandoned

Date

NOV 23 1932

CHAS. L. SHERWOOD

192

Scout

M^c Pherson

Map No. KANSAS Sec. 20 Twp. 19 R. 1^w


Well No. 3 Loggersment Farm
Werby Oil Company

_____ Ft. from N. Line

330' Ft. from S. Line

_____ Ft. from E. Line

330' Ft. from W. Line

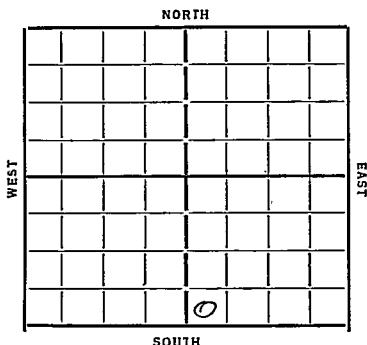

Date 1933

REPORT

<u>5/10</u>	<u>Log.</u>
<u>5/17</u>	<u>—</u>
<u>5/24</u>	<u>—</u>
<u>6/1</u>	<u>R.O.G.</u>
<u>6/8</u>	<u>—</u>
<u>6/15</u>	<u>—</u>
<u>6/21</u>	<u>—</u>
<u>6/28</u>	<u>Rig</u>
<u>7/5</u>	<u>—</u>
<u>7/12</u>	<u>12" - 207 dely 690'</u>
<u>7/19</u>	<u>Top L.L. Lino 2355</u>
<u>7/26</u>	<u>Base Lino 3155 dely 3255'</u>
<u>8/2</u>	<u>Cement 6" 3409 Top Viola</u>
<u>8/9</u>	<u>T.D. 3418 swab 30 oil 10 water 7 hrs</u>
<u>8/17</u>	<u>1000 gal acid swab 100 lbs oil 90 water 12 hrs</u>
<u>8/23</u>	<u>Viola 3409 - 3418 T.D. 177 lbs oil some water</u>

COMPLETED

McPherson

43 KANSAS

W

Map No. Sec. 30 Twp. 19 R. 1

Well No. 3 Locuement

Derby Oil Co

Company

Contractor

FIRST REPORTS

Ft. from N. Line

330 Ft. from S. Line

Ft. from E. Line

330 Ft. from W. Line

SECTION PLAT

Location ✓

Rig up

Drilling and Remarks:

RECORD

Cased in, ft.

Sand

Gas

Oil

Total Depth

PRODUCTION

1st 24 hrs. Nat.

1st 24 hrs. after shot

Gas Cu. Ft.

Dry Hole

Abandoned

Date

MAY 10 1933

CHAS. L. SHERWOOD

Scout

Form 26-1M Dts 26
McPherson

Map No. _____ Sec. *20* Twp. *19* R. *1W*

Well No. *43* *3- Loquemont*

Derby oil Company

Contractor

SECTION PLAT

_____ Ft. from N. Line

330 Ft. from S. Line

_____ Ft. from E. Line

330 Ft. from W. Line

COMPLETED

Location _____

Rig up _____

Drilling and Remarks:

Viola 3409

177 oil
Some water

RECORD

Cased _____ in., _____ ft.

Sand _____

Gas _____

Oil _____

Total Depth *3418*

PRODUCTION

1st 24 hrs. Nat. _____

1st 24 hrs. after shot _____

Gas _____ Cu. Ft.

Dry Hole _____

Abandoned _____

Date

8/23/33 192 *O. Manschub* 8000