

McPherson

Map No. KANSAS Sec. 20 Twp. 19 R. 1 W

Well No. 3-Mc Gill Farm

T. C. Johnson Company


_____ Ft. from N. Line

330 Ft. from S. Line

_____ Ft. from E. Line

990 Ft. from W. Line

Elev. 1575

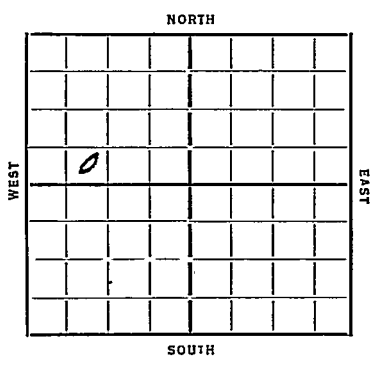

Date _____ REPORT

7/17 Kelly Rig
 8/8 dly 10500 15 1/2 464
 8/15 " 1645 13" 1435
 8/22 10" 2160 HFW 2165 ~~to 2160~~
 8/29 -
 9/6 10" 2330 16 @ 2340
 T C 2928 2900 2975
 HFW 3005-16 6" 3130
 9/25 Viola 3413
 T 7 3431
 1000 acid
 113 lbs.

COMPLETED

KANSAS

Map No. 43 Sec. 20 Twp. 19 R. 1W

Well No. 3-McGill

T.C. Johnson Company

T.C. Johnson Contractor

FIRST RECORD

SECTION PLAT

..... Ft. from N. Line

330 Ft. from S. Line

..... Ft. from E. Line

990 Ft. from W. Line

0			

Location.....

Rig up.....

Drilling and Remarks:

Bed of King

RECORD

Cased..... in., ft.

Sand.....

Gas.....

Oil.....

Total Depth.....

PRODUCTION

1st 24 hrs. Nat.....

1st 24 hrs. after shot.....

Gas..... Cu. Ft.

Dry Hole.....

Abandoned.....

Date

7-17-35 1935

ORVAL MANNING

Scout

Map No. 43 Sec. 20 Twp. 19 R. 1W

Well No. 3-McBille

T. C. Johnson Company

Contractor

COMPLETED

SECTION PLAT

Ft. from N. Line

330 Ft. from S. Line

Ft. from E. Line

990 Ft. from W. Line

Location

Rig up

Drilling and Remarks:

1000 and

113 ffb

RECORD

Cased in., ft.

Sand Viola 3413

Gas

Oil

Total Depth 3431

PRODUCTION

1st 24 hrs. Nat.

1st 24 hrs. after shot:

Gas Cu. Ft.

Dry Hole

Abandoned

Date

9-25-35 192

ROYAL MANSCHRECK

Scout