

Map No. KANSAS Sec. 20 Twp. 19 R. 1^W

Well No. 4-Stage Farm
Darby Pitt et al Company


990 Ft. from N. Line

_____ Ft. from S. Line

330 Ft. from E. Line

_____ Ft. from W. Line

1931

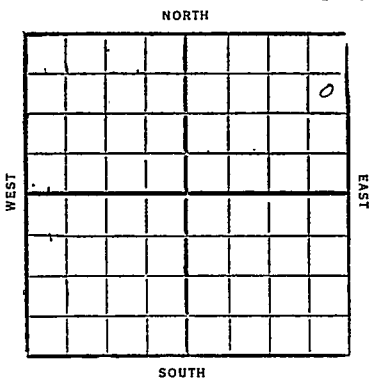

Date	REPORT
9/30	Viola line test
10/7	CSG
10/14	Bldg rotary rig
10/21	706' sur pipe
10/28	Drg 2020
11/4	Top Chat 2904
11/10	Drg 3094
11/18	8" 3104
11/23	Drg 3108'
11/23	Base Miss. line 3108 -
11/23	Top Viola 3371 - Filled up
11/23	600 ft while pulling tools -
11/23	Now setting 5" csq.
11/24	(Telephone)
11/24	Top Viola 3371 3367
11/24	6" - 3163
11/24	Hole full oil 24 hr
11/24	Drg 5" csq
12/2	Top Viola 3367 (corrected)
12/2	T.D. 3371 Hole full oil
12/2	No test

12/9- T.D. 3371

swab 180 bbl 9 1/2 hrs
Deepened to

T.D. 3377

swab 142 bbl 6 hrs
swabbing 500 ft
off bottom
drlg 3378'

12/16- Viola 3367-90

Cased 5"- 3365

shot 5 qt 3367-87

Clog out

12/22- T.D. 3390

swab 322 bbl 10 hrs
Clog out & swabbing

12/30- T.D. 3390'

No test

1932

1/6- T.D. 3390

Est 800 bbl oil

1/13- T.D. 3390

swab 480 bbl 6 1/2 hrs

1/20- S.D. 3390'

1/27- Cased 5"- 3365'

Viola 3367-90

T.D. 3390

shot 15 qt 3367-87

Made 480 bbl 6 1/2 hrs

shut in

Comp.

43

McPherson

Map No. KANSAS Sec. 20 Twp. 19 R. 1 ^W

Well No. 4 *Kaegi*

Darby *put* *et* *al* Company

Contractor

FIRST REPORTS

990 Ft. from N. Line

..... Ft. from S. Line

330 Ft. from E. Line

..... Ft. from W. Line

SECTION PLAT

			o

biola lime test

Location.....

Rogey

Rig up.....

Drilling and Remarks:

RECORD

Cased..... in., ft.

Sand.....

Gas.....

Oil.....

Total Depth.....

PRODUCTION

1st 24 hrs. Nat.....

1st 24 hrs. after shot.....

Gas..... Cu. Ft.

Dry Hole.....

Abandoned.....

Date

SEP 30 1931

CHAS. L. SHERWOOD

192

Scout

McPherson

43 KANSAS

Map No. _____ Sec. 20 Twp. 19 R. 1 W

Well No. 4 *Kaezi*

Darley Inc Co et al Company

Contractor

COMPLETED

SECTION PLAT

990 Ft. from N. Line

_____ Ft. from S. Line

330 Ft. from E. Line

_____ Ft. from W. Line

			o

Location _____

Rig up _____

Drilling and Remarks:

Shot 15' 3367-87

480 Bbls 6 1/2 Hours.

Shut in.

RECORD

Cased .5 in., 3365 ft.

Sand *Uola* 3367-90

Gas _____

Oil _____

Total Depth 3390

PRODUCTION

1st 24 hrs. Nat. _____

1st 24 hrs. after shot _____

Gas _____ Cu. Ft.

Dry Hole _____

Abandoned _____

Date
JAN 27 1932

CHAS. L. SHERWOOD

19

Scout