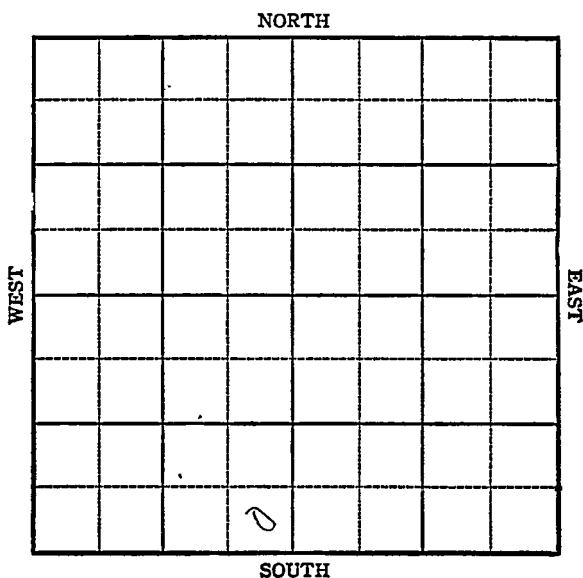


KANSAS

McPherson

Section 12 Township 19 Range 1WWell No. #1 VothCompany Delka Oil Corp. -

Well No. #1 Voth Farm


Delka Okl Corp. _____ Company

NORTH

330 Ft. from S. Line

330 Ft. from E. Line

Ft. from W. Line

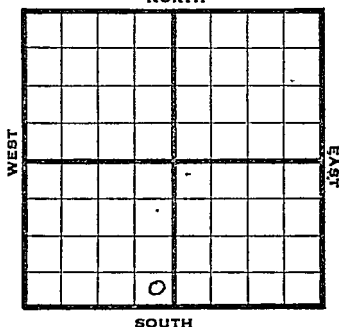

McPhe rson SE SW

SOUTH

1944

REPORT

11/28

SH

12/6

8" @ 127

Drlg. 1900

12/14

Miss #2872-2873

TD 2873

5" @ 2873' RUST

12/21

11 11 11 11

12/27

Miss 2872-

5" @ 2873


TD 2917

ABANDONED

Pool Name WildcatMap No. 43 Sec. 12 Twp. 19 R. 1WWell No. 1 VothDeika OIL Corp. CompanyFIRST REPORT Contractor

SE SW

SECTION PLAT

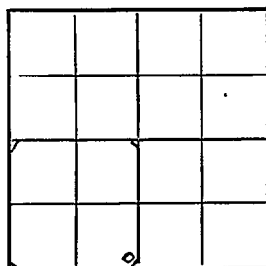 Ft. from N. Line330 Ft. from S. Line330 Ft. from E. Line Ft. from W. LineMcPhersonLocation Rig up

Drilling and Remarks:

S H

RECORD

Cased in., ft.Sand Gas Oil Total Depth

PRODUCTION

1st 24 hrs. Nat. 1st 24 hrs. after shot Gas Cu. Ft.Dry Hole Abandoned

Date

NOV 29 1944

19

S. I. LEWIS Scout

Pool Name WildcatMap No. 43 Sec. 12 Twp. 19 R. 1WWell No. 1 VothDelka Oil Corp. CompanyABANDONED Contractor

SE SW

SECTION PLAT

 Ft. from N. Line330 Ft. from S. Line330. Ft. from E. Line Ft. from W. Line

McPherson County

Location Rig up

Drilling and Remarks:

*Mis 2872**5' 0" 2873*

RECORD

Cased in., ft.Sand Gas Oil Total Depth 2917

PRODUCTION

1st 24 hrs. Nat. 1st 24 hrs. after shot Gas Cu. Ft.Dry Hole Abandoned

Date

DEC 27 1944

19

S. J. LEWIS

Scout