

KANSAS


McPherrson

FORM 51 5M 1-42 PETROL

Section 14 Township 19 Range 1 W

Well No. 1 O.L.Hutchinson

Company Williams & Borine

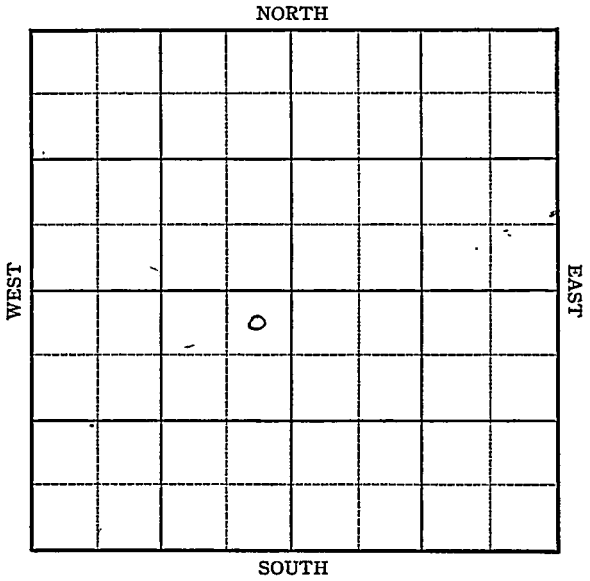

KANSAS

McPheerrson

Sec. 14 Twp. 19 R. 1-W

Well No. #1 O. L. Hutchinson Farm


Williams & Borine Company

330 Ft. from N. Line

_____ Ft. from S. Line

330 Ft. from E. Line

_____ Ft. from W. Line

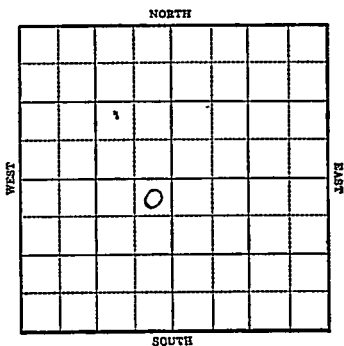

1943

R E P O R T

11/17 8" @ 146'
WOC.

12-1 Lang 2305
Miss 2876
TD 2895

ABANDONED

Map No. KAN 218 723 Sec. 14 Twp. 19 R. 1W

Well No. 10. L. Hutchinson

Williams & Borine Company

FIRST REPORT Contractor

NE SW

SECTION PLAT

330 Ft. from N. Line

_____ Ft. from S. Line

330 Ft. from E. Line

_____ Ft. from W. Line

Wildcat

Location _____

Rig up _____

Drilling and Remarks:

8" - 146' WOC

RECORD

Cased _____ in., _____ ft.

Sand _____

Gas _____

Oil _____

Total Depth _____

PRODUCTION

1st 24 hrs. Nat. _____

1st 24 hrs. after shot _____

Gas _____ Cu. Ft.

Dry Hole _____

Abandoned _____

Date

NOV 17 1943 19

S. J. LEWIS Scout

Map No. KAN 243 Sec. 14 Twp. 19 R. 1W

Well No. 1 O. L. Hutchinson

Williams & Borine Company

ABANDONED Contractor

NE SW

330 Ft. from N. Line

_____ Ft. from S. Line

330 Ft. from E. Line

_____ Ft. from W. Line

SECTION PLAT

	o		

Wildcat

Location _____

Rig up _____

Drilling and Remarks:

Loss 2305
Miss 2876

RECORD

Cased _____ in., _____ ft.

Sand _____

Gas _____

Oil _____

Total Depth 2895

PRODUCTION

1st 24 hrs. Nat. _____

1st 24 hrs. after shot _____

Gas _____ Cu. Ft.

Dry Hole _____

Abandoned _____

Date

DEC 1 1943 19

S. J. LEWIS

Scout