

Butler

KANSAS

SEC.	TWP.	R.
6	27	6 E

WELL NO. # 1 Sluss FARM

COMPANY Frank Strait

CONTRACTOR


Leon

Ft. from N. Line

Ft. from S. Line

Ft. from E. Line

Ft. from W. Line

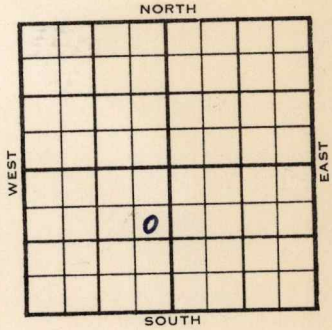

SE NE SW (Twin)

	ELEVATION	REPORT
1955		
11/9	Comm. 9-20-55 13" @ 1017 10" @ 1575 8" @ 2310 7" @ 2805 5" @ 3098 PB 2800 24/2742-48 S/wtr. 1000 A S/wtr. TD 3127 D & A KC 2135' M. 2738' V. 3119'	<p style="text-align: center;">FIRST REPORT ↓ ABANDONED</p>

County Butler Elev. _____
 Sec. 6 Twp. 27 Rge. 6E
 Company Frank Strait
 Farm Name Sluss No. 1

TOPS	DEPTH	LOG	DATUM
Anh.			
Tp.			
H.			
Tr.			
Dg.			
B.L.			
L.			
K.C.	2135		
B.K.C.			
Ce.			
C.	2738		
M.			
M.			
K.			
Mz.			
Mq.			
V.	3119		
S.			
S.			
A.			
R.			
Pe.			
G.			
T.D.	3127		

Loc. in Sec. _____
SE NE SW
(twin)
 Geol. _____
 Contr. _____
 Pool _____
Leon
 FIRST REPORT
 NOV 19 58
 ABANDONED

Date Comm. 9-20-55
13" @ 1017 10" @ 1575 8" @ 2310
7" @ 2805 5" @ 3098 PB 2800
2 1/2 / 2742-48 S/ wtr. 1000 A S/ wtr.
TD 3127 D & A

Co.
 Lsc.
 No.
 Sec.
 T.
 R.