


McPherson

KANSAS

SECTION 16 TOWNSHIP 19S RANGE 1W

WELL NO. #1 Waln

COMPANY Geo. Hess

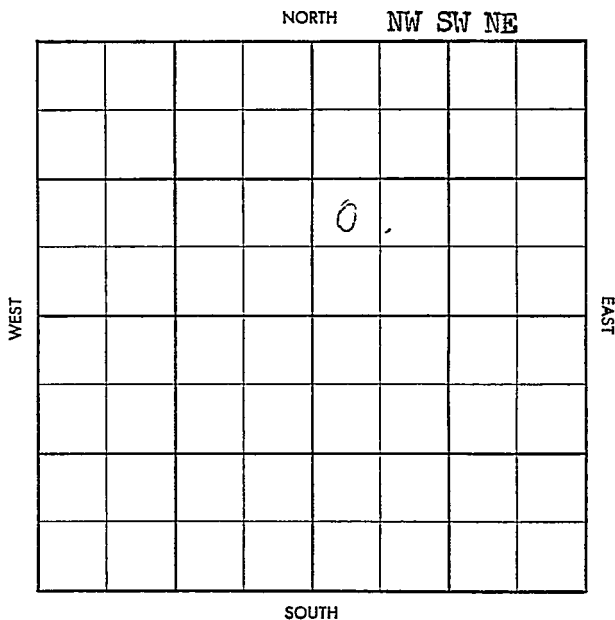

~~Twp.~~ ~~Pool~~
~~Co.~~ ~~Facet~~

County McPherson Elev. _____
 Sec. 16 Twp. X19 Rge. 1W
 Company Geo. Hess
 Farm Name Waln No. 1

TOPS	DEPTH	LOG	DATUM
Anh.			
Tp.			
H.			
Tr.			
Dg.			
B.L.			
L.			
K.C.			
B.K.C.			
Ce.			
C.			
M.			
M.			
K.			
Mz.			
Mq.			
V.			
S.			
S.			
A.			
R.			
Pf.			
G.			
T.D.			

Loc. in Sec. _____
NW SW NE
 Geol. _____
 Contr. _____
Mallard
 Pool _____
Ritz Canton

JUN 18 '58
FIRST REPORT

Date Comm. 6-13-58
8" @ 170, Drlg. 1878

Co.
Lse.
No.
Sec.
T.
R.