


Section 15 Township 19 Range 1W

Well No. #1 Vasholtz

Company Anschutz

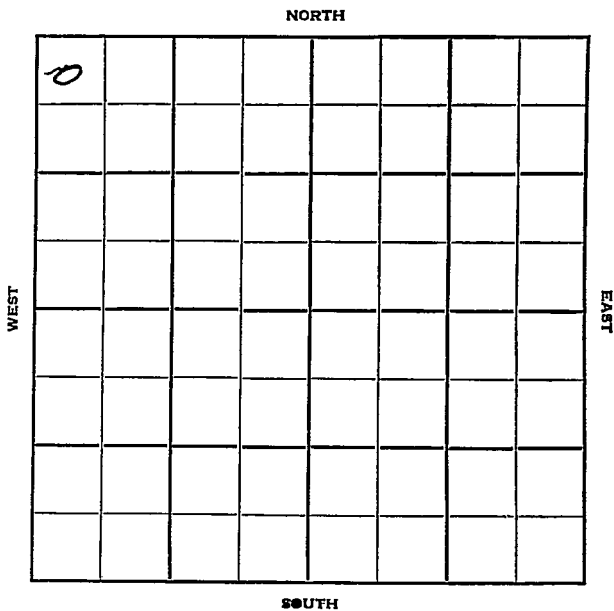

Sec. 15 Twp. 19 R. 1W

Well No. #1 Vasholtz Farm

Anschutz Company

Honaker Contractor

Wildcat


330 Ft. from N. Line

_____ Ft. from S. Line

_____ Ft. from E. Line

330 Ft. from W. Line

NW NW NW

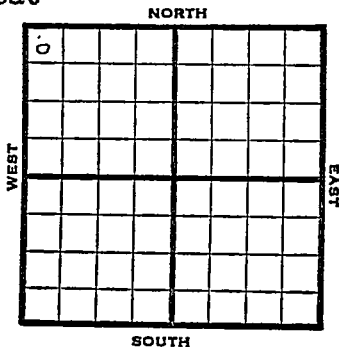

1952 Elev. 1577' REPORT

7/2	Location	
7/9	"	
7/17	"	
7/23	"	
8/30	8" @ 205	
	Drlg. 500'	
8/6	Heeb. 2102'	Douglas 2142
	Lans. 2342	
	Drlg. 2860'	
8/13	Spud 7-26-52	
	D&A TD 2974	8" @ 205
	Heeb 2102	Doug. 2142
	Lans. 2342	Cong. 2918
	Miss. 2923	
	TD 2974 D&A	

ABANDONED

County **McPherson** State **Kansas**

Sec. **15** (Blk. Twp.) **19** (Sur. Rge.) **1W** Map No.

Operator **Anschutz**

Well No. **1** Farm **Vasholtz**

Elev. **1577** Location **NW NW NW**

0					

330 Ft. From **N** Line **NW**

330 Ft. From **W** Line **Quarter**

1st. Report **JUL 2 1952**

Completion

Remarks

Honaker - Contr.

Spudding Date

Drilg. Data **Wildcat**

Location

J. G. McGEHEE

County McPherson State Kansas

Sec. 15 (Blk. Twp.) 19 (Sur. Rge.) 1W Map No.

Operator Anschutz Drlg.

Well No. 1 Farm Vasholtz

Elev. 1577 Location NW NW NW

o							

330 Ft. From N Line NW

330 Ft. From W Line Quarter

1st. Report

Completion AUG 13 1952

Remarks

Honaker Drlg. - Contr.

Spudding Date 7-26-52

ABANDONED

Drlg. Data D & A TD 2974

8" @ 205 Heeb. 2102 Doug. 2142

Lans. 2342 Cong. 2918 Miss. 2923

TD 2974

D & A