

16

19


1W

SECTION _____ TOWNSHIP _____ RANGE _____

WELL NO. #1 Blodgett

COMPANY Cal-Jones

NORTH NW SW SW

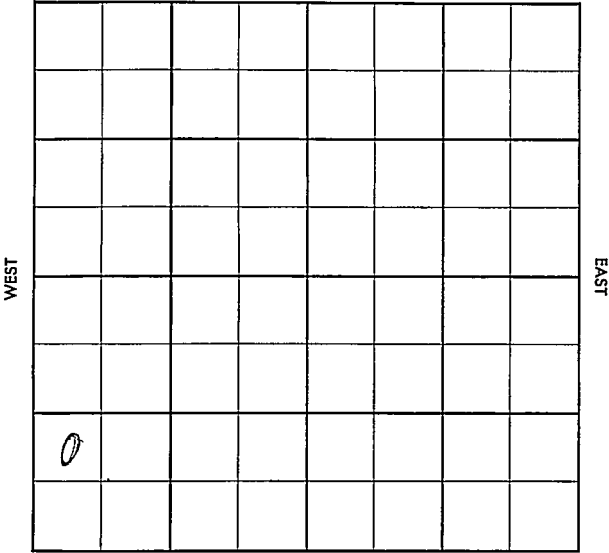

SOUTH

County McPherson Elev. _____
 Sec. 16 Twp. 19 Rgs. 1W
 Company Cal-Jones
 Farm Name Blodgett No. 1

TOPS	DEPTH	LOG	DATUM
Anh.			
Tp.			
H.			
Tr.			
Dg.			
Bl.			
L.			
K.C.			
B.K.C.			
Ce.			
C.			
M.			
M.			
K.			
Mz.			
Mo.			
V.			
S.			
S.			
A.			
R.			
PE.			
G.			
T.P.			

Loc. in Sec. NW SW SW
 Geol. _____
 Contr. _____
Melland Tool
 Pool _____
Ritz Canton

FIRST REPORT			
		FEB 13 1957	
0			

Date Comm. 2-16-57
 gll @ 150/110 Drlg. 2329

||

Co.
 L.S.G.
 No.
 Sec.
 T.
 R.

Co.

County McPherson Elev. 1581
 Sec. 16 Twp. 19 Rge. 1W
 Company Cal-Jones
 FarmName Blodgett No. 1

TOPS	DEPTH	LOG	DATUM	Loc. in Sec.
Anh				NW SW SW
Ip				
H.				
Tr.				
Dg				
Bl.				
L.				Geol.
K.C.				Contr.
B.K.C.				Melland Tool
Ce.				Pool
C.				Ritz Canton
M. <u>chat</u>	<u>2932</u>			
M.				
K.				
Mz.				
Mo.				
V.	<u>3411</u>			
S.				
S.				
A.				
R.				
PE.				
G.				
TD	<u>3413</u>			

Melland Tool

Ritz Canton

COMPLETE

MAR 6 '57

18

No.

Sec.

T.

R.

Date Comm. 2-16-57
 8" @ 150/110 Drlg. 2329 FEB 20 '57

5 1/2' 3413 FEB 27 57 Back Top.
Miss chat 2932 no show woct
MIC T CO DD 3415 \$
15-20 Bopd + wtc NAT TO POP
P. 26 Bopd + wtc