


Kansas

Map No. _____ Sec. 11 Twp. 32 R. 05

Well No. 1 Mofzett Farm
Maple Crest Company

NORTH

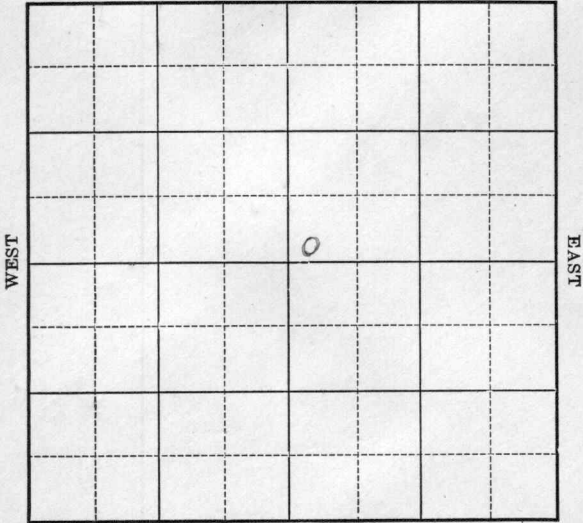

SOUTH

Location _____

Drilling Remarks:

Rig Up _____

Drilling Remarks:

RECORD

Cased _____ in. _____ ft.

Sand _____

Gas _____

Oil _____

Total Depth _____

PRODUCTION

1st 24 hrs. Nat. _____

1st 24 hrs. after shot _____

Gas _____ cu. ft.

Dry Hole _____

Abandoned _____

Map No. KV Sec. 11 Twp. 32 R. 5

Well No. 1 Mappett

Mable Oil Co Company

Contractor

FIRST REPORT

SECTION PLAT

----- Ft. from N. Line
200 Ft. from S. Line
 ----- Ft. from E. Line
200 Ft. from W. Line

		0	

Location -----

Rig up -----

Drilling and Remarks:

Rig

RECORD

Cased ----- in., ----- ft.

Sand -----

Gas -----

Oil -----

Total Depth -----

PRODUCTION

1st 24 hrs. Nat. -----

1st 24 hrs. after shot -----

Gas ----- Cu. Ft.

Dry Hole -----

Abandoned -----

Date

JUL 27 1922

M. A. BENEAR

191

Scout

Map No. **KANSAS** Sec. *11* Twp. *32* R. *5*

Well No. *1 Maffell*

Noble Oil & L. Company

Contractor

ABANDONED SECTION PLAT

Ft. from N. Line

200 Ft. from S. Line

Ft. from E. Line

200 Ft. from W. Line

RECORD

Location -----

Rig up -----

Drilling and Remarks:

Cased ----- in., ----- ft.

Sand -----

Gas -----

Oil -----

Total Depth -----

PRODUCTION

1st 24 hrs. Nat. -----

1st 24 hrs. after shot -----

Gas ----- Cu. Ft.

Dry Hole -----

Abandoned *3282*

Date

JAN 6 1923

M. A. BENEAR

191 -----

Scout