


McPherson

KANSAS

SECTION 17 TOWNSHIP 19S RANGE 1W

WELL NO. #1 Becker

COMPANY Cal Jones

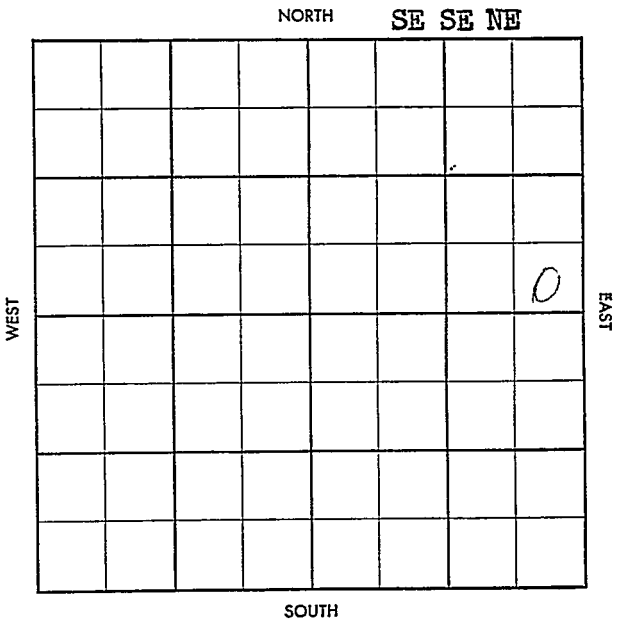

~~Pool~~  
~~Pool~~

S-513-B

County McPherson Elev. \_\_\_\_\_  
 Sec. 17 Twp. (19) Rge. 1W  
 Company Cal Jones  
 Farm Name Becker No. 1

TOPS	DEPTH	LOG	DATUM
Anh.			
Tp.			
H.			
Tr.			
Dg.			
B.L.			
L.			
K.C.			
B.K.C.			
Ce.			
C.			
M.			
M.			
K.			
Mz.			
Mq.			
V.			
S.			
S.			
A.			
R.			
Pf.			
G.			
T.D.			

Loc. in Sec. \_\_\_\_\_  
 App SE SE NE  
(Twin Well)  
 Geol. D. Melland  
 Contr. \_\_\_\_\_  
Melland tools  
 Pool \_\_\_\_\_  
Ritz-Canton

**FIRST REPORT**  
 APR 9 1958

Date Comm. 4/5/58  
10" @ 165 w/135, Drlg. 756.

Co. \_\_\_\_\_  
 Lsg. \_\_\_\_\_  
 No. \_\_\_\_\_  
 Sec. \_\_\_\_\_  
 T. \_\_\_\_\_  
 R. \_\_\_\_\_

Twp. X Pool X  
 Co. \_\_\_\_\_ Facet X

S-513-B

County McPherson Elev 15810 or 15840  
 Sec. 17 Twp. 19 Rge. 1W  
 Company Cal Jones  
 Farm Name Becker No. 1

TOPS	DEPTH	LOG	DATUM
Anh.			
Tp.			
H.			
Tr			
Dg.			
B.L.			
L.			
K.C.			
B.K.C.			
Ce.			
C.			
M.	<u>2919</u>		
M.			
K.			
Mz.			
Mq.			
V.	<u>3394</u>		
S.			
A.			
R.			
Pf.			
G.			
T.D.	<u>3396</u>		

Loc. in Sec. \_\_\_\_\_  
 App SE SE NE  
 (Twin Well)  
720  
1748  
 Geol. D. Melland  
 Contr. \_\_\_\_\_  
Melland tools  
 Pool \_\_\_\_\_  
Ritz-Canton

**COMPLETE**  
 MAY 21 '58

Date Comm. 4/5/58  
ION. 165 w/135, Drlg. 756. APR 16 58 DST  
2969 - 88 8 1/2 hrs 900 SW BHP  
700/20 no log 7" 3395  
APR 23 58 CO DD 3397 1/2 TD \$ 8 BOPh  
+ 60% w 8 hrs A \$ APR 30 58 380  
ph + 3 BW ph 8 hrs pop MAY 7 58  
MAY 14 58 MAY 21 58 P 36 BOPd + 70 BWpd  
P 25 BOPd + 50 BWpd  
Visib open hole 3395 - 97 1/2

Co.  
No.  
Sec.  
T.  
R.