


DX 78-1

Section 17 Township 19 Range 1W

Well No. 1 German

Company DeDozier Oil

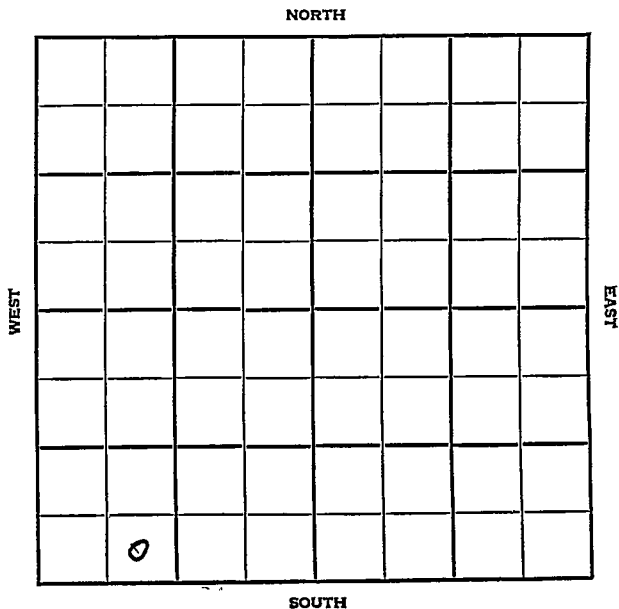

McPherson KANSAS

SEC.	TWP.	R.
17	19	1 W

WELL NO. # 1 German FARM

COMPANY Dozier Oil

CONTRACTOR Stag Drlg.
Ritz-Canton Pool


_____ Ft. from N. Line

330 _____ Ft. from S. Line

_____ Ft. from E. Line

990 _____ Ft. from W. Line

SE SW SW

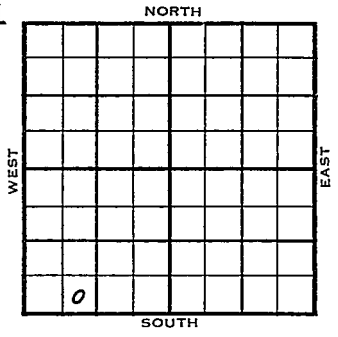

	ELEVATION	REPORT
1954	1571'	
6/23	8" @ 140	Drlg. 1755'
6/30	Miss 2943'	RT ^U 2980'
	5" @ 2975'	
7/7	WOCT	
7/21	Spud 6-19-54	Oil well TD 2981
	8" @ 140	Miss 2943 TD 2980
	5" @ 2975	DD 2981 sd-frac.
	500 A frac	S/3 BOPH 8 hr.
	70% wtr.	Comp. 14 BOPD 90% wtr.
	COMPLETED	

