


Section 12 Township 32 Range 5E

Well No. 1 Hawley

Company Beaumont Pet.

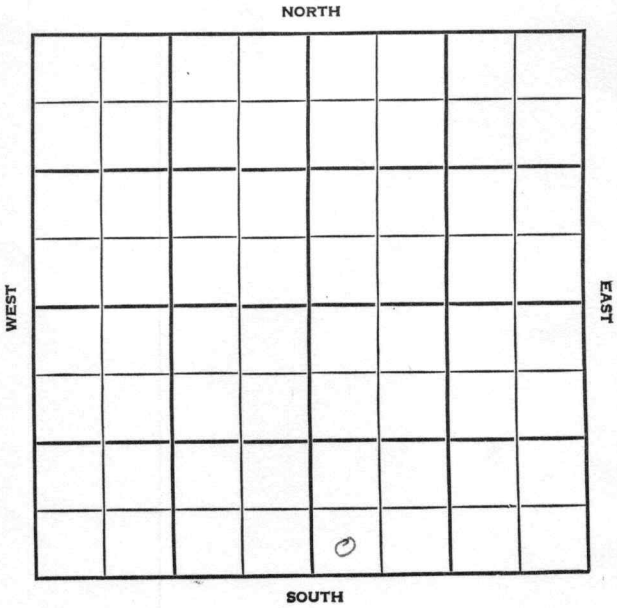

HOT FILE

Cowley

KANSAS

| | | |
|---------|---------|--------|
| SEC. 12 | TWP. 32 | R. 5 E |
|---------|---------|--------|

WELL NO. # 1 Hawley FARM

COMPANY Beaumont Pet.

CONTRACTOR Co. tools


Silver Creek Pool

_____ Ft. from N. Line

330 _____ Ft. from S. Line

_____ Ft. from E. Line

330 _____ Ft. from W. Line

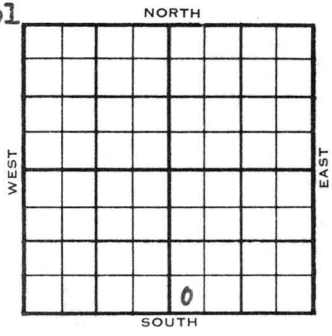

SW SW SE

(1/2 mile Sunray)

| | ELEVATION | REPORT |
|------|--|---|
| 1955 | 1304' | |
| 3/30 | Spud 3-15-55 10" @ 97 | Layton 2270 KC 2439 B KC 2558 Mar. 2647 Cherokee 2775 Bart 2943' Miss 3043' TD 3062' 7" @ 3062 WOC |
| 5/26 | NR | |
| 6/2 | No report. | |
| 6/9 | Layton 2270', KC 2439', B KC 2558' Marm. 2647', Cherokee 2775', Bart 2943' Miss 3043' RTD 3062' 7" @ 3062 54/3025-31, G/1 MCFG. SP 3010 12/2982-84 Comp. shut in gas well. | |

COMPLETED

County Cowley Elev. 1304
 Sec. 12 Twp. 32 Rge. 5E
 Company Beaumont P. t.
 Farm Name Hawley No. 1

| TOPS | DEPTH | LOG | DATUM |
|--------------------|------------------|-----|-------------|
| Anh. | | | |
| Tp. | | | |
| H. | | | |
| Tr. | | | |
| Dg. | | | |
| Bl. | | | |
| L. <u>ayton</u> | <u>2270-2392</u> | | <u>966</u> |
| K.C. | <u>2439</u> | | <u>1135</u> |
| B.K.C. | <u>2558</u> | | <u>1254</u> |
| Ce. | | | |
| C. | | | |
| M. | | | |
| M. <u>aym</u> | <u>2647</u> | | <u>1343</u> |
| K. <u>Cherokee</u> | <u>2775</u> | | <u>1471</u> |
| Mz. <u>Bast</u> | <u>2943</u> | | <u>1639</u> |
| Mg. <u>Miss</u> | <u>3043</u> | | <u>1739</u> |
| V. | | | |
| S. | | | |
| S. | | | |
| A. | | | |
| R. | | | |
| PE. | | | |
| G. | | | |
| T.D. | <u>3062</u> | | |

Loc. in Sec. SW SW SE

Geol. _____

Contr. _____

Pool _____

Silver Creek

| | |
|----------|--|
| | |
| COMPLETE | |
| | |

Date Comm. 3-15-55 JUN 8 1955

10" @ 97/100 7" @ 3062 54/ 3025-31

1 mcfg SP 3010 12/ 2982-84

Comp. shut in gas well

Co.
Lse.
No.
Sec.
T.
R.