


Section 12 Township 32 Range 5 E

Well No. #2 Hawley

Company Beaumont Pet.

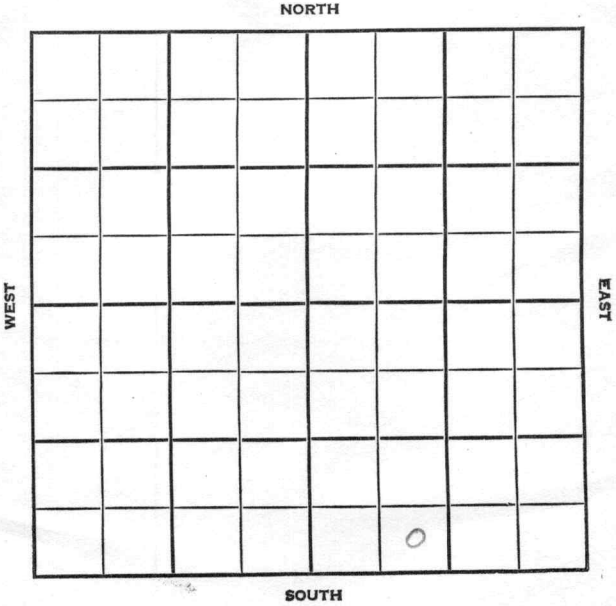

O. W. D. D Cowley

KANSAS

SEC. 12	TWP. 32	R. 5E
------------	------------	----------

WELL NO. #2 Hawley FARM

COMPANY Beaumont Petr.

CONTRACTOR Co. Tools


Winfield

\_\_\_\_\_ Ft. from N. Line

\_\_\_\_\_ Ft. from S. Line

\_\_\_\_\_ Ft. from E. Line

\_\_\_\_\_ Ft. from W. Line

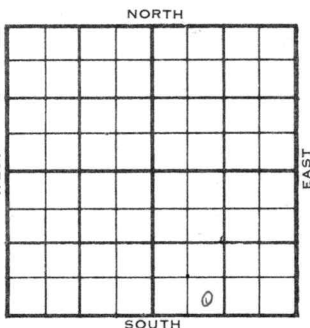

SE SW SE

	ELEVATION	REPORT
1956		
2-1		Cellar & pits
2/29		Spud 1-31-56 8-5/8" @ 129 <del>w/1100</del> w/100 CO 3022'. Pf 23/2998-3002' frac (VSSO) lots wtr. TD 3077' D & A M. Chert 3065' M. Li 3072'
		<b>ABANDONED</b>
		<b>O. W. D. D</b>
3/7		OTD 3077' DD 3097' 2 BO 18 hr. 1000 A.
3-21		Comp. 15 bopd, 40 bw M. ch. 3065' M. Li. 3072' TD 3077'
		<b>COMPLETED</b>

County Cowley Elev. \_\_\_\_\_  
 Sec. 12 Twp. 38 Rge. 5E  
 Company Beaumont Pet.  
 Farm Name Hawley No. 2

TOPS	DEPTH	LOG	DATUM	Loc. in Sec.
Anh.				SE SW SE
Tp.				
H.				
Tr.				
Dg.				
Bl.				
L.				Geol. _____
K.C.				Contr. _____
B.K.C.				Co. tools
Ce.				
C.				
M.				Pool
M.				Winfield
K.				
Mz.				
Me.				
V.				
S.				
S.				
A				
R.				
PE.				
G.				
T.D.				

FIRST REPORT  
 FEB 1 '55

Date Comm. Cellar & pits

\_\_\_\_\_  
 \_\_\_\_\_  
 \_\_\_\_\_  
 \_\_\_\_\_  
 \_\_\_\_\_  
 \_\_\_\_\_

Co.

Lse.

No.

Sec.

T.

R.

County Cowley Elev. 1316  
 Sec. 12 Twp. 23 Rgn. 5E  
 Company Beaumont Pet.  
 Farm Name Hawley No. 2

TOPS	DEPTH	LOG	DATUM	Loc. in Sec.
Ank				SE SW SE
TP				
H. <u>624</u>	<u>2297</u>		<u>981</u>	
T. <u>Base top</u>	<u>2412</u>		<u>1096</u>	
Dg				
Bl				
L				
KC	<u>2457</u>		<u>1141</u>	Geol.
BXC	<u>2574</u>		<u>1258</u>	Conts
Co. <u>Marin</u>	<u>2664</u>		<u>1351</u>	Co. tools
sh <u>cherty sh</u>	<u>2794</u>		<u>1478</u>	
M. <u>Top Blk.</u>	<u>2799</u>		<u>1483</u>	
N. <u>chert</u>	<u>3065</u>		<u>1749</u>	Pool
PF <u>M. L.</u>	<u>3072</u>		<u>1756</u>	Winfield
Ms				
Mq				
V.				
S.				
S.				
A				
R.				
PC				
G.				
SA	<u>3077</u>			

ABANDONED

FEB 29 1956

Date Comm. Cellar & pits FEB 8 56 1-31-56  
8 5/8 129 1100 10 2145 FEB 15 56  
CRD 2983-3013 Full Rec. CRD  
3013-65 Full Rec 5 1/2 3077 / FEB 22 56  
Co 24/3042-46 150' wtr in  
hole in 16 Mar FEB 29 56 Frac  
wtr 50d PF Co 3022 23/  
2998-3002 Frac (VSSO) Lots  
wtr 12 5/8

O. W. D. D.

FORM 513 REV. SUNRAY

OWDD

County Cowley Elev. \_\_\_\_\_  
 Sec. 12 Twp. 32 Rgs. 5E  
 Company Beaumont Pet.  
 Farm Name J. H. Hawley No. 2

TOPS	DEPTH	LOG	DATUM	Loc. in Sec.
Anh.				SE S W SE
TP.				
H.				
Tr.				
Dg.				
Bl.				
L.				Geol. _____
K.C.				Contr. _____
B.K.C.				
Ce.				
C.	<del>NO RECORD</del>			
M.				Pool _____
M.				<u>Winfield</u>
K.				
Mz.				
Mq.				
V.				
S.				
S.				
A.				
R.				
PE.				
G.				
T.D.				

FIRST REPORT  
 MAR 7 '56  
 0

Date Comm. OTD 3077 DD 3 097 2 60 18 hr. 1000 A

Co.  
Lse.  
No.  
Sec.  
T.  
R.

OWDD

County Cowley Elev. \_\_\_\_\_  
 Sec. 12 Twp. 32 Rge. 5E  
 Company Beaumont Pet.  
 Farm Name J. H. Hawley No. 2

TOPS	DEPTH	LOG	DATUM
Anh.			
Tr.			
H.			
Tr.			
Dg.			
Bl.			
L.			
K.C.			
B.K.C.			
Ce.			
C.			
M. <u>cb</u>	<u>3065</u>		
M. <u>Li</u>	<u>3072</u>		
K.			
Mz.			
Mq.			
V.			
S.			
S.			
A.			
R.			
Pe.			
G.			
T.D.	<u>3077</u>		

Loc. in Sec. SE SW SE  
 Geol. \_\_\_\_\_  
 Contr. \_\_\_\_\_  
 Pool Winfield

COMPLETE
----------

Date Comm. MAR 21 1956  
OTD 3077 DD 3097 2 bo 18 hr.  
1000 A Comp. 15 bopd 40 bw

Co. Lse. No. Sec. T. R.