


McPherson

KANSAS

SECTION 17 TOWNSHIP 19S RANGE 1W

WELL NO. #1 Nevenschwander

COMPANY V.C. Culver

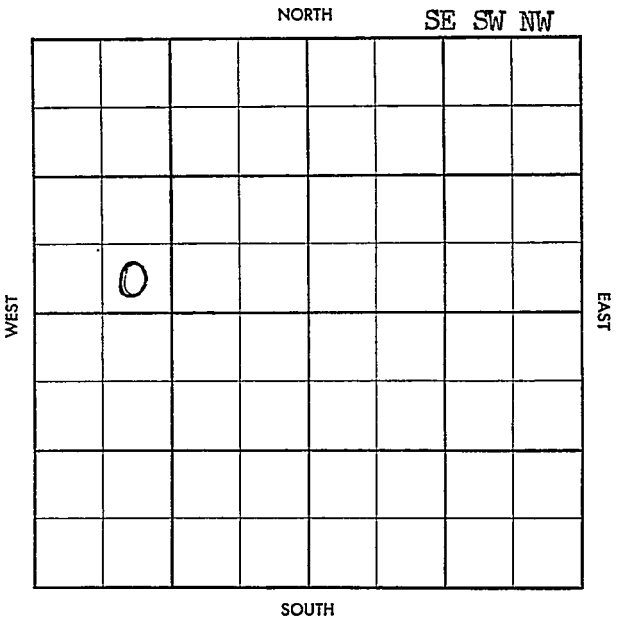



County McPherson Elev. _____
 Sec. 17 Twp. 19 Rge. TW
 Company V. C. Culver
 Farm Name Nevenschwander No. 1

Co.

TOPS	DEPTH	LOG	DATUM
Anh.			
Tp.			
H.			
Tr.			
Dg.			
Bl.			
L.			
K.C.			
B.K.C.			
Ce.			
C.			
M.			
M.			
K.			
Mz.			
Me.			
V.			
S.			
S.			
A			
R.			
PE.			
G.			
TR.			

Loc. in Sec. _____
 SE SW NW
 Geol. _____
 Contr. _____
Mallard
 Pool _____
Ritz-Canton

Lse.

FIRST REPORT		
0	1/2	1/4

No.

Date Comm. 9-11-57
8" @ 215/100 drlg. 1920

No.

Sec.

T.

R.

County McPherson Elev. _____
 Sec. 17 Twp. 19 Rge. 1W
 Company V. C. Culver
 Farm Name Nevenschwander No. 1

TOPS	DEPTH	LOG	DATUM	Loc. in Sec.
Anb.				SE SW NW
TP.				
H.				
Tr.				
Dg.				
Bl.				
L.	<u>2334</u>			Geol. _____
K.C.				Contr. _____
B.K.C.				
Ce.				<u>Mallard</u>
C.				
M.	<u>2946</u>			Pool _____
M.	<u>3018</u>			<u>Ritz-Canton</u>
K.				
Mz.				
Mo.				
V.				
S.				COMPLETE
S.				
A.				
R.				
PE.				
G.				
TD.	<u>2991</u>			OCT 2 '57

Date Comm. 9-14-57
8" @ 215/100 drlg. 1920

5 1/2 2984 OCT 2 '57 DD 3020TD
630 lot w A 530pd + 13BW
ph. SD

530pd + 200BW

open 2984 - 3020

Co.
Lse.
No.
Sec.
T.
R.